

LAND CORNER RECORDATION CERTIFICATE
Filing Requirement of Act 74, Mich. P.A. 1970

Alcona County
Remonumentation
Liber 1 Page 174

For corners in
Alcona
(County)

Located In:

Corner Code #

RECORDED

- 1. Public Land Survey T 26N R 8E
T 26N R 9E
T _____ R _____
T _____ R _____
- 2. Property Controlling in Section S _____ T _____ R _____
S _____ T _____ R _____
- 3. Miscellaneous S _____ T _____ R _____
Property in Section S _____ T _____ R _____

M-9
A-9

Date: 9-26-96
County Rep: E.T.L.

APPROVED LAND CORNER
P.A. 345 of 1990
ALCONA COUNTY

SEP 24 2 42 PM '96

David B. Guthrie
REGISTER OF DEEDS
ALCONA COUNTY, MICHIGAN

Register of Deeds Stamp & File Number

- 4. Lot No. _____, Recorded Plat _____
- 5. Private Claims _____

A	B	C	D	E	F	G	H	I	J	K	L	M
2	6	5	4	3	2	1						
3												
4	7	8	9	10	11	12						
5												
6	18	17	16	15	14	13						
7												
8	19	20	21	22	23	24						
9												
10	30	29	28	27	26	25						
11												
12	31	32	33	34	35	36						
13												

I, David B. Guthrie in a field survey on June 28, 1996, do hereby certify that under requirements of P.A. 74, Michigan P.A. of 1970, the corner points mentioned in lines 1 and 2 above were in conformance with regulations and rules therefore as required in the current manual of survey instructions of the United States Department of the Interior, Bureau of Land Management or by a decree of a Court of Law and/or that the corner points mentioned in lines 3, 4 and 5 above were in conformance with the rules of the Michigan Board of Professional Surveyors or by a Decree of a Court of Law; established, re-established, monumented, re-monumented, recovered, found as expressed below:

NOTE: Not more than 4 corners, all in the same town and range, may be recorded on this certificate.

A. Description of original monument and accessories and/or subsequent restoration:

1838: G.L.O. Survey by Lewis Clason - Set Post and Referenced
Hem. 24 - S53W - 30 / Hem. 14 - N28W - 43

1901: Survey by Edw. Chapelle - Set a 3 cornered reddish Boulder with glass under it.

B. Description of corner evidence found and/or method applied in restoring or reestablishing corner:

1996: Found a 1/2" Iron Rod

SURVEY &
REMONUMENTATION


DEC 16 1996

COMMISSION

C. Description of monument for corner and accessories established to perpetuate locating the position of the corner:

1996: Set a 1/2" x 24" Iron Rod with a Brass Cap stamped to identify the corner placed in a Monument Box.

- Referenced: S20°E - 15" Spruce - 66.16 Feet
- S75°E - 6" Ash - 32.63 Feet
- N55°W - Utility Pole - 89.50 Feet
- S85°W - 3" Ash - 113.02 Feet

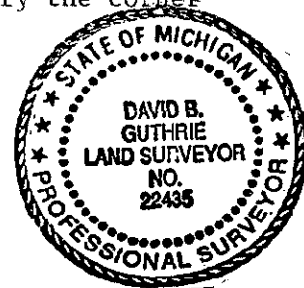

Signed by David B. Guthrie

Date Sept. 17, 1996

Surveyor's Michigan License No. 22435