

LAND CORNER RECORDATION CERTIFICATE
 Filing Requirement of Act 74, Mich. P.A. 1970

Alcona County
 Remonumentation
 Liber 1 Page 168

For corners in Alcona (County) Located In: Corner Code #

1. Public Land Survey	T <u>26N</u> R <u>8E</u>	<u>M-11</u>
	T <u>26N</u> R <u>9E</u>	<u>A-11</u>
	T _____ R _____	_____
	T _____ R _____	_____
2. Property Controlling in Section	S _____ T _____ R _____	_____
	S _____ T _____ R _____	_____
3. Miscellaneous Property in Section	S _____ T _____ R _____	_____
	S _____ T _____ R _____	_____

4. Lot No. _____, Recorded Plat _____

5. Private Claims _____

RECORDED

SEP 24 2 43 PM '96

David A. Guthrie
 REGISTERED PROFESSIONAL SURVEYOR

Register of Deeds Stamp & File Number

Date 9-28-96
 County Rep. E.T.L.
 P A 345 of 1990
 ALCONA COUNTY

A	B	C	D	E	F	G	H	I	J	K	L	M
2	6	5	4	3	2							
3												
4	7	8	9	10	11	12						
5												
6	18	17	16	15	14	13						
7												
8	19	20	21	22	23	24						
9												
10	30	29	28	27	26	25						
11												
12	31	32	33	34	35	36						
13												

I, David B. Guthrie in a field survey on July 12, 1996, do hereby certify that under requirements of P.A. 74, Michigan P.A. of 1970, the corner points mentioned in lines 1 and 2 above were in conformance with regulations and rules therefore as required in the current manual of survey instructions of the United States Department of the Interior, Bureau of Land Management or by a decree of a Court of Law and/or that the corner points mentioned in lines 3, 4 and 5 above were in conformance with the rules of the Michigan Board of Professional Surveyors or by a Decree of a Court of Law; established, re-established, monumented, re-monumented, recovered, found as expressed below:

NOTE: Not more than 4 corners, all in the same town and range, may be recorded on this certificate.

- A. Description of original monument and accessories and/or subsequent restoration:**
- 1838: G.L.O. Survey by Lewis Clason - Set Post and Referenced Hd Maple 30 - S54W - 16 / Beech 16 - N47W - 72
 - 1901: Survey by Edw. Chapelle - Set light gray Boulder with old Monument and crockery under it.
 - 1906: Survey by Edw. Chapelle - Stone
 - 1972: Survey by James L. Scott - Liber 148, Page 67.


- B. Description of corner evidence found and/or method applied in restoring or reestablishing corner:**
- 1996: Found 1/2" Iron Rod 3 Feet West of the Centerline of the North South Road.

**SURVEY &
 REMONUMENTATION**

DEC 16 1996

COMMISSION

- C. Description of monument for corner and accessories established to perpetuate locating the position of the corner:**
- 1996: Set a 1/2" x 24" Iron Rod with a Brass Cap stamped to identify the corner placed in a Monument Box.
 Referenced: N62°W - 30" Maple - 64.50 Feet
 S47°W - 18" Maple - 43.55 Feet
 N38°W - Fe. Cor. Post - 46.20 Feet
 N60°E - Utility Pole - 105.65 Feet

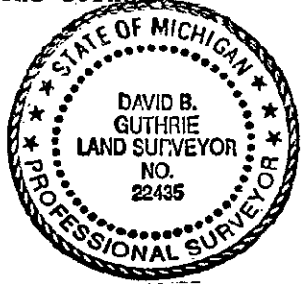

Signed by *David B. Guthrie* Date Sept. 20, 1996