1996 Alcona County Remonumentation Corner

LAND CORNER RECORDATION CERTIFICATE
Filing Requirement of Act 74, Mich. P.A. 1970

Alcona County Remonumentation Liber 1 Page 174

RECORDED

SEP 24 2 42 PM '96

Register of Deeds Stamp & File Number

APPROVED LAND CORNER P A 345 of 1990 ALCONA COUNTY

County Rep E.T.L. Date 9-20-96

For corners in Alcona (County)

	Located In:	Corner Code #
1. Public Land Survey	T 26N R 8E	M-9
	T 26N R 9E	A-9
	T ___ R ___	
	T ___ R ___	
2. Property Controlling	S ___ T ___ R ___	
in Section	S ___ T ___ R ___	
3. Miscellaneous	S ___ T ___ R ___	
Property in Section	S ___ T ___ R ___	

4. Lot No. _____, Recorded Plat _____
5. Private Claims _____

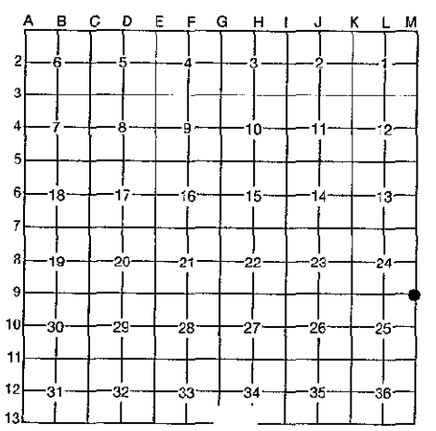

I, David B. Guthrie, in a field survey on June 28, 19 96, do hereby certify that under requirements of P.A. 74, Michigan P.A. of 1970, the corner points mentioned in lines 1 and 2 above were in conformance with regulations and rules therefore as required in the current manual of survey instructions of the United States Department of the Interior, Bureau of Land Management or by a decree of a Court of Law and/or that the corner points mentioned in lines 3, 4 and 5 above were in conformance with the rules of the Michigan Board of Professional Surveyors or by a Decree of a Court of Law; established, re-established, monumented, re-monumented, recovered, found as expressed below:

NOTE: Not more than 4 corners, all in the same town and range, may be recorded on this certificate.

A. Description of original monument and accessories and/or subsequent restoration:

1838: G.L.O. Survey by Lewis Clason - Set Post and Referenced
Hem. 24 - S53W - 30 / Hem. 14 - N28W - 43

1901: Survey by Edw. Chapelle - Set a 3 cornered reddish Boulder with glass under it.

B. Description of corner evidence found and/or method applied in restoring or reestablishing corner:

1996: Found a 1/2" Iron Rod

SURVEY & REMONUMENTATION
DEC 1 6 1996
COMMISSION

C. Description of monument for corner and accessories established to perpetuate locating the position of the corner:

1996: Set a 1/2" x 24" Iron Rod with a Brass Cap stamped to identify the corner placed in a Monument Box.
Referenced: S20°E - 15" Spruce - 66.16 Feet
S75°E - 6" Ash - 32.63 Feet
N55°W - Utility Pole - 89.50 Feet
S85°W - 3" Ash - 113.02 Feet

STATE OF MICHIGAN
DAVID B. GUTHRIE
LAND SURVEYOR
NO. 22435
PROFESSIONAL SURVEYOR

Signed by David B. Guthrie Date Sept. 17, 1996

Surveyor's Michigan License No. 22435

FORM APPROVED BY MICHIGAN STATE BOARD OF PROFESSIONAL SURVEYORS, JAN. 28, 1971
REVISED MAY 14, 1975
REVISED JAN., 1983