

FEB 17 1994

27 001 PAGE 52

COMMISSION Alcona County Remonumentation Corner

LAND CORNER RECORDATION CERTIFICATE Filing Requirement of Act 74, Mich. P.A. 1970

For corners in

Alcona (County) Located In: Corner Code # 1. Public Land Survey T 26N R 9E C-5 2. Property Controlling in Section S T R 3. Miscellaneous Property in Sec. S T R

Alcona County DEEDS Remonumentation Liber 1 Page 52 DEC 29 3 23 PM '93

David A. Bantline REGISTER OF DEEDS ALCONA COUNTY, MICHIGAN

Register of Deeds Stamp & File Number

4. Lot No. , Recorded Plat 5. Private Claims

I, David B. Guthrie in a field survey on December 23, 1993, do hereby certify that under requirements of P.A. 74, Michigan P.A. of 1970, the corner points mentioned in lines 1 and 2 above were in conformance with regulations and rules therefore as required in the current manual of survey instructions of the United States Department of the Interior, Bureau of Land Management or by a decree of a Court of Law and/or that the corner points mentioned in lines 3, 4 and 5 above were in conformance with the rules of the Michigan Board of Land Surveyors or by a Decree of a Court of Law; established, re-established, monumented, re-monumented, recovered, found as expressed below:

NOTE: Not more than 4 corners, all in the same town and range, may be recorded on this certificate.

Grid table with columns A-L and rows 2-13. A dot is present at row 5, column C.

A. Description of original monument and accessories and/or subsequent restoration:


- 1843: G.L.O. Survey by Lewis Clason. Set post and referenced: Beech 20 - S77E - 07 Beech 14 - N60W - 26 1901: Alcona County Survey - Set dark boulder with glass and earthenware. 1965: M.D.S.H. Survey - 1 1/2" Iron Pin, Referenced. 1981: Survey by John F. Oliver - Found 5/8" Iron Rod in Monument Box and referenced.

B. Description of corner evidence found and/or method applied in restoring or reestablishing corner:

- 1993: Found 5/8" Iron Rod in Monument Box at the road intersection.

C. Description of monument for corner and accessories established to perpetuate locating the position of the corner:

- 1993: Placed brass cap stamped to identify the corner on a 5/8" Iron Rod in a Monument Box. Referenced: N05°E - 18" Beech - 193.61 Feet N30°E - Utility Pole - 87.23 Feet N46°W - 20" Apple - 170.31 Feet N45°W - Stop Sign - 69.70 Feet

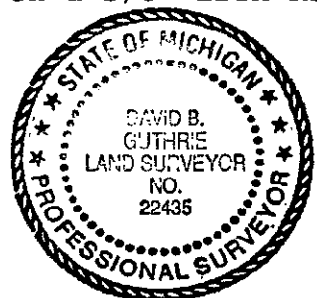

Signed by [Signature]

Date December 27, 1993

Surveyor's Michigan License No. 22435