

REMONUMENTATION

FEB 17 1994

COMMISSION

570 001 PAGE 54

Alcona County Remonumentation Corner
LAND CORNER RECORDATION CERTIFICATE
Filing Requirement of Act 74, Mich. P.A. 1970

Alcona County
Remonumentation
Liber 1 Page 54

For corners in

Alcona <small>(County)</small>	Located In:	Corner Code #
1. Public Land Survey	T <u>26N</u> R <u>9E</u>	<u>E - 5</u>
	T _____ R _____	_____
	T _____ R _____	_____
	T _____ R _____	_____
2. Property Controlling in Section	S _____ T _____ R _____	_____
	S _____ T _____ R _____	_____
3. Miscellaneous Property in Sec.	S _____ T _____ R _____	_____
	S _____ T _____ R _____	_____
4. Lot No. _____, Recorded Plat _____		
5. Private Claims _____		

RECORDED

DEC 29 3 24 PM '93

David A. Guthrie
REGISTER OF DEEDS
ALCONA COUNTY, MICHIGAN

Register of Deeds Stamp & File Number

I, David B. Guthrie in a field survey on December 23, 1993, do hereby certify that under requirements of P.A. 74, Michigan P.A. of 1970, the corner points mentioned in lines 1 and 2 above were in conformance with regulations and rules therefore as required in the current manual of survey instructions of the United States Department of the Interior, Bureau of Land Management or by a decree of a Court of Law and/or that the corner points mentioned in lines 3, 4 and 5 above were in conformance with the rules of the Michigan Board of Land Surveyors or by a Decree of a Court of Law; established, re-established, monumented, re-monumented, recovered, found as expressed below:

NOTE: Not more than 4 corners, all in the same town and range, may be recorded on this certificate.

A. Description of original monument and accessories and/or subsequent restoration:


- 1843: G.L.O. Survey by Lewis Clason. Set post and referenced Hemlock 18 - S65E - 18 Cedar 14 - N28W - 18
- 1901: Alcona County Survey - Set gray flinty boulder with glass and crockery.
- 1965: M.D.S.H. Survey - Set 1" Iron bar

B. Description of corner evidence found and/or method applied in restoring or reestablishing corner:

1993: Found 5/8" Rod in Monument Box at the road intersection.

C. Description of monument for corner and accessories established to perpetuate locating the position of the corner:

- 1993: Placed a brass cap stamped to identify the corner on a 5/8" Iron Rod in a Monument Box. Referenced:
N08°W - Utility Pole - 207.08 Feet
N13°W - Utility Pole - 92.58 Feet
N16°E - Fence Cor. Post - 182.61 Feet
S13°E - Utility Pole - 193.40 Feet

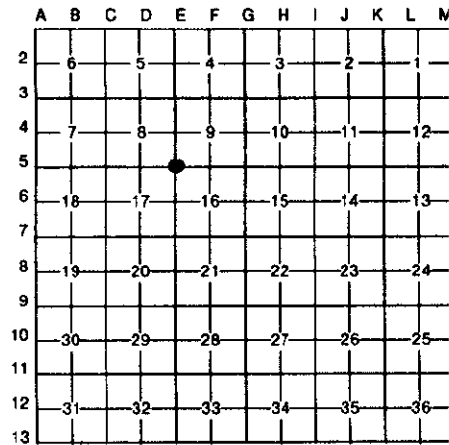

Signed by *David B. Guthrie* Date December 27, 1993

Surveyor's Michigan License No. 22435

