

1998 Alcona County Remonumentation

LAND CORNER RECORDATION CERTIFICATE
Filing Requirement of Act 74, Mich. P.A. 1970

Alcona County
Remonumentation
Liber 1 Page 288

For corners in

Alcona

(County)

Located In:

Corner Code #

1. Public Land Survey

T 26NR 09E

G-12

T R

T R

T R

2. Property Controlling
in Section

S T R

S T R

3. Miscellaneous
Property in Sec.

S T R

S T R

4. Lot No. _____, Recorded Plat _____

5. Private Claims _____

I, Wayne T. Lewis, in a field survey on 7-29, 19 98 do hereby state that under requirements of P.A. 74, Michigan P.A. of 1970, the corner points mentioned in lines 1 and 2 above were in conformance with regulations and rules therefore as required in the current manual of survey instructions of the United States Department of the Interior, Bureau of Land Management or by a decree of a Court of Law and for that the corner points mentioned in lines 3, 4 and 5 above were in conformance with the rules of the Michigan Board of Land Surveyors or by a Decree of a Court of Law, established, re-established, monumented, recovered, found as expressed below:

NOTE: Not more than 2 corners, all in the same town and range, may be recorded on this certificate.

Filed for Record in
ALCONA COUNTY MICHIGAN
DORIS A GAUTHIER
On 11-05-1998 At 04:38:22 pm.
LAND CORNER 9.00
DR

APPROVED LAND CORNER
P A 345 of 1990
ALCONA COUNTY
Date 10/28/98
County Rep. D. P. B. Ten
Register of Deeds Stamp & File Number

	A	B	C	D	E	F	G	H	I	J	K	L	M
1													
2	6		5		4		3		2		1		
3													
4	7		8		9		10		11		12		
5													
6	18		17		16		15		14		13		
7													
8	19		20		21		22		23		24		
9													
10	30		29		28		27		26		25		
11													
12	31		32		33		34		35		36		
13													

A. Description of original monument and accessories and/or subsequent restoration:

- 1843: J. MULLET - SET POST AND WITNESSED
- 1994: NORTHEAST LAND SURVEYS (BILL WOODS, P.S. AND JOHN OLIVER, P.S.) - SET BAR AND CAP AND RECORDED SURVEYS, NO WITNESSES GIVEN
- 1995: DAVID B. GUTHRIE, P.S. - FOUND 1/2" IRON ROD WITH CAP (NELS), RECORDED SURVEY AND WITNESSED

SURVEY &
REMONUMENTATION

NOV 25 1998

B. Description of corner evidence found and/or method applied in restoring or reestablishing corner:

FOUND 1/2" REROD W/CAP (UNIDENTIFIABLE) 11.3' EAST OF NORTH/SOUTH ROAD C/L

SECTION


THIS CORNER POSITION IS ACCEPTED AS A CAREFUL AND FAITHFUL PERPETUATION OF THE POSITION OF THE ORIGINAL CORNER.

C. Description of monument for corner and accessories established to perpetuate locating the position of the corner:

1998: PLACED 3" ALCONA COUNTY CAP, STAMPED TO IDENTIFY THE CORNER, OVER EXISTING 1/2" REROD

WITNESSES:

- S 35° E 20.16' 40" OAK (TAG #22435)
- N 60° E 24.17' 36" MAPLE (TAG #22435)
- N 25° E 59.08' 40" OAK (TAG #22435)
- S 45° W 122.20' POWER POLE (TAG #25882)

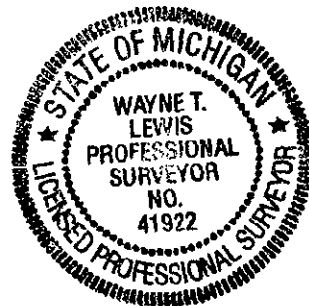

Signed by

Wayne T. Lewis

Surveyor's Michigan License No. _____

41922

Date November 2, 1998