

SURVEY & REMONUMENTATION

DEC 1 8 1996

COMMISSION

1996 ALCONA COUNTY REMONUMENTATION CORNER
LAND CORNER RECORDATION CERTIFICATE
 Filing Requirement of Act 74, Mich. P.A. 1970

Alcona County
 Remonumentation
 Liber 1 Page 201

For corners in Alcona (County) Located In: _____ Corner Code # _____

- 1. Public Land Survey T 26N R 9E K-4
 T _____ R _____ Harrisville Twp
 T _____ R _____
 T _____ R _____
- 2. Property Controlling S _____ T _____ R _____
 in Section S _____ T _____ R _____
- 3. Miscellaneous S _____ T _____ R _____
 Property in Section S _____ T _____ R _____

APPROVED LAND CORNER
 P A 345 of 1990
 ALCONA COUNTY
 11/15/96
 Date
 County Rep

RECORDED

Nov 18 8 45 AM '96

James A. Santolin
 REGISTERED
 COUNTY CLERK

Register of Deeds Stamp & File Number

- 4. Lot No. _____, Recorded Plat _____
- 5. Private Claims _____

A	B	C	D	E	F	G	H	I	J	K	L
2	6	5	4	3	2						
3											
4	7	8	9	10	11	12					
5											
6	18	17	16	15	14	13					
7											
8	19	20	21	22	23	24					
9											
10	30	29	28	27	26	25					
11											
12	31	32	33	34	35	36					
13											

I, Thomas L. Fabis, in a field survey on November 8, 19 96, do hereby certify that under requirements of P.A. 74, Michigan P.A. of 1970, the corner points mentioned in lines 1 and 2 above were in conformance with regulations and rules therefore as required in the current manual of survey instructions of the United States Department of the Interior, Bureau of Land Management or by a decree of a Court of Law and/or that the corner points mentioned in lines 3, 4 and 5 above were in conformance with the rules of the Michigan Board of Professional Surveyors or by a Decree of a Court of Law; established, re-established, monumented, re-monumented, recovered, found as expressed below:

NOTE: Not more than 4 corners, all in the same town and range, may be recorded on this certificate.

A. Description of original monument and accessories and/or subsequent restoration:

- 1838: G.L.O. Survey by Lewis Clason - Set post & referenced: (B. Ash 6 - S56E - 34, Cedar 6 - N42E - 24).
- 1965: State Highway Survey by G.G. Slattery - Found 6" x 6" Conc. Mon. with Brass Cap and referenced.
- 1980: Survey (W.O. 1-1267) by David Guthrie of R.S. Scott Assoc. - Found Conc. Mon. and referenced.


B. Description of corner evidence found and/or method applied in restoring or reestablishing corner:

- 1996: Found State of Michigan Conc. Monument with brass cap and 4 existing witnesses matching G.G. Slattery's witnesses of 1965.

This corner is accepted as a careful and faithful perpetuation of the position of the original corner.

C. Description of monument for corner and accessories established to perpetuate locating the position of the corner:

- 1996: Existing State of Michigan Conc. Monument with brass cap.
 Existing witnesses are as follows:
 N20W 21.80' 12" Blazed Cedar
 N60W 38.90' 10" Blazed Cedar
 S35W 44.68' 14" Blazed Cedar
 N10W 70.50' 8" Blazed Cedar

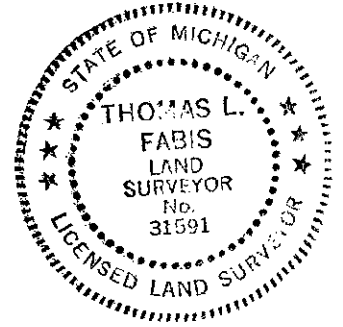

Signed by Thomas L. Fabis Date November 14, 1996

Surveyor's Michigan License No. 31591