

SURVEY & REMONUMENTATION

DEC 16 1995

COMMISSION

1996 ALCONA COUNTY REMONUMENTATION CORNER

LAND CORNER RECORDATION CERTIFICATE
Filing Requirement of Act 74, Mich. P.A. 1970

Alcona County
 Remonumentation
 Liber 1 Page 199
RECORDED

For corners in

Alcona
 (County)

Located In:

Corner Code #

1. Public Land Survey

T 26N R 9E

L-1

T _____ R _____

Harrisville

T _____ R _____

T 27N R 9E

L-13

2. Property Controlling
 in Section

S _____ T _____ R _____

Haynes Twp.

S _____ T _____ R _____

3. Miscellaneous
 Property in Section

S _____ T _____ R _____

S _____ T _____ R _____

4. Lot No. _____, Recorded Plat _____

5. Private Claims _____

APPROVED LAND CORNER
 P.A. 345 of 1990
 ALCONA COUNTY
 Date 11-15-96
 County Rep. E. J. [Signature]

Nov 18 8 44 AM '96
 [Signature]
 REGISTER OF DEEDS
 ALCONA COUNTY
Register of Deeds Stamp & File Number

T26N - R9E

	A	B	C	D	E	F	G	H	I	J	K	M
2	6	5	4	3	2	1						
3												
4	7	8	9	10	11	12						
5												
6	18	17	16	15	14	13						
7												
8	19	20	21	22	23	24						
9												
10	30	29	28	27	26	25						
11												
12	31	32	33	34	35	36						
13												

I, Thomas L. Fabis, in a field survey on November 8, 1996, do hereby certify that under requirements of P.A. 74, Michigan P.A. of 1970, the corner points mentioned in lines 1 and 2 above were in conformance with regulations and rules therefore as required in the current manual of survey instructions of the United States Department of the Interior, Bureau of Land Management or by a decree of a Court of Law and/or that the corner points mentioned in lines 3, 4 and 5 above were in conformance with the rules of the Michigan Board of Professional Surveyors or by a Decree of a Court of Law; established, re-established, monumented, re-monumented, recovered, found as expressed below:

NOTE: Not more than 4 corners, all in the same town and range, may be recorded on this certificate.

A. Description of original monument and accessories and/or subsequent restoration:

- 1838: G.L.O. Survey by Lewis Clason - Set Post & referenced: (Hem 12 - N11W - 18, Cedar 6 - N20E - 11)
- 1901: County Survey by Ed Chapelle - Visited Corner & referenced.
- 1939: County Survey by Andrew Freer - 1/4 stake 2 horseshoes & broken glass
- 1976: Survey (R.S. Scott W.O. 1-1144) by David Guthrie - Found 1" Pipe & referenced.
- 1992: MDOT Survey and L.C.R.C. (Liber 1 Page 443) by Clifford Lindgren - Found 1" Pipe and referenced.

B. Description of corner evidence found and/or method applied in restoring or reestablishing corner:


1996: Found 1" Pipe in centerline of gravel road and 4 existing witnesses as per M.D.O.T. Survey of 1992 and R.S. Scott Survey of 1976.

The position of this corner is compatible with local surveys and is accepted as a careful and faithful perpetuation of the position of the original corner.

C. Description of monument for corner and accessories established to perpetuate locating the position of the corner:

1996: Set 1/2" iron rod inside existing 1" Pipe and capped it with a 3" dia. aluminum cap stamped to identify the corner, 6" below gravel surface.

- References:
- 12" Maple - N25W - 31.72'
 - 7" Aspen - S12E - 14.58'
 - 8" Aspen - S62W - 40.52'
 - Dead Aspen - S76W - 52.16'

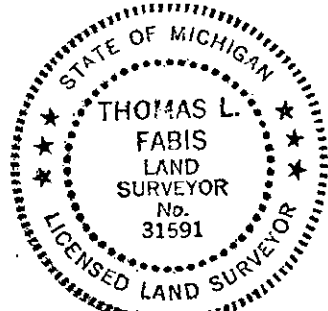

Signed by Thomas L. Fabis

Date November 13, 1996

Surveyor's Michigan License No. 31591