

DEC 16 1996

1996 ALCONA COUNTY REMONUMENTATION CORNER

COMPLIANT LAND CORNER RECORDATION CERTIFICATE

FILING REQUIREMENT OF ACT 74, MICH. P.A. 1970 RECORDED

FOR CORNERS OF--:	LOCATED IN--:	CORNER CODE NUMBER
1. PUBLIC LAND SURVEY	T. 27N N. S., R. 5E E. W.	G-9
2. PROPERTY CONTROLLING IN SECTION	, T. N. S., R. E. W.	
3. MISCELLANEOUS PROPERTY IN SECTION	, T. N. S., R. E. W.	
4. LOT NO. _____, RECORDED PLAT _____		
5. PRIVATE CLAIMS _____		

Alcona County Remonumentation Liber Page 186

OCT 23 2 15 PM '96

James A. Matthews REGISTERED LAND SURVEYOR MICHIGAN

APPROVED LAND CORNER P A 345 of 1990 ALCONA COUNTY Date 9-10-96 County Rep. E.T.L. REGISTER OF DEEDS STAMP AND FILING NUMBER


I, John F. Oliver do hereby certify that under requirements of P.A. 74, Michigan P.A. of 1970, the corner points mentioned in lines 1 and 2 above (identified with circles on index code diagram - over) were, in a field survey on Sept. 27, 1996, established, re-established, monumented, re-monumented, recovered or restored as expressed below and in conformance with regulations and rules therefore as required in the current manual of survey instructions of the United States Department of the Interior, Bureau of Land Management or by a decree of a court of law. Furthermore, that the corner points mentioned in lines 3, 4 and 5 above were, in a field survey on \_\_\_\_\_ 19\_\_\_\_, found, recovered, restored, established or re-established as expressed below and in conformance with the rules of the Michigan State Board of Registration for Land Surveyors or, by a Decree of a Court of law:

- A. Description of original monument and accessories and/or subsequent restoration:
  - 1840: G.L.O. Survey by T. Patterson - Set Post and Referenced Sugar 16 / N20°W / 16 - Hemlock 10 / S15°E / 18
  - 1994: Survey by F. King - Found Pipe-no cap - ± 2' North of c/l of bit. Road to East and ± 2' East of c/l of gravel Road to North and South.

- B. Description of corner evidence found and/or method applied in restoring or re-establishing corner:
  - 1996: Found 3/4" Pipe and confirmed its location with the F. King Survey.

- C. Description of monument for corner and accessories established to perpetuate locating the position of the corner:
  - 1996: Replaced with 1/2" Rod and Aluminum Cap stamped to identify the Corner. Referenced -

- N75°W / 13" Double Maple 52.13'
- S35°W / 17" Beech / 113.60'
- S5°E / 32" Double Maple / 154.23'
- S40°W / Util. Pole / 51.32'

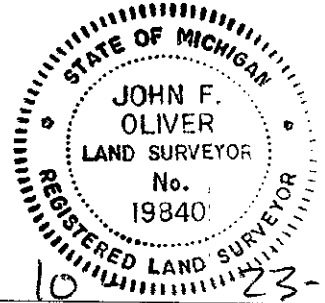

SIGNED BY \_\_\_\_\_ DATE 10-23-96

SURVEYOR'S MICHIGAN REGISTRATION NO. 19840 (SEAL)

FOR STATE AND UNITED STATES AGENCIES: SIGNED BY \_\_\_\_\_ CHIEF OF SURVEY PARTY DATE \_\_\_\_\_

APPROVED AND SIGNED BY \_\_\_\_\_ MICHIGAN REGISTERED LAND SURVEYOR DATE \_\_\_\_\_ (SEAL)

SURVEYOR'S MICHIGAN REGISTRATION NO. \_\_\_\_\_