

DEC 16 1996

1996 ALCONA COUNTY REMONUMENTATION CORNER

COMMISSION LAND CORNER RECORDATION CERTIFICATE

FILING REQUIREMENT OF ACT 74, MICH. P.A. 1970 RECORDED

FOR CORNERS OF--:	LOCATED IN--:	CORNER CODE NUMBER
1. PUBLIC LAND SURVEY	T. 27N N. S., R. 5E E. W.	H-9
2. PROPERTY CONTROLLING IN SECTION	, T. N. S., R. E. W.	
3. MISCELLANEOUS PROPERTY IN SECTION	, T. N. S., R. E. W.	
4. LOT NO. _____, RECORDED PLAT _____		
5. PRIVATE CLAIMS _____		

Alcona County Remonumentation Liber Page 1/1

Oct 23 2 15 PM '96

James A. Guthrie
REGISTERED DEEDS
MICHIGAN

APPROVED LAND CORNER
P A 345 of 1990
ALCONA COUNTY

Date: 10-16-96

REGISTER OF DEEDS STAMP AND FILING NUMBER

I, John F. Oliver do hereby certify that under requirements of P.A. 74, Michigan P.A. of 1970, the corner points mentioned in lines 1 and 2 above (identified with circles on index code diagram - over) were, in a field survey on Sept 27, 1996, established, re-established, monumented, re-monumented, recovered or restored as expressed below and in conformance with regulations and rules therefore as required in the current manual of survey instructions of the United States Department of the Interior, Bureau of Land Management or by a decree of a court of law. Furthermore, that the corner points mentioned in lines 3, 4 and 5 above were, in a field survey on _____ 19____, found, recovered, restored, established or re-established as expressed below and in conformance with the rules of the Michigan State Board of Registration for Land Surveyors or, by a Decree of a Court of law:

A. Description of original monument and accessories and/or subsequent restoration:

- 1840: G.L.O. Survey by T. Patterson - Set Post and Referenced Hemlock 15 / N29°E / 7 - Hemlock 14 / S46°W / 19
- 1905: Survey by E. Chapelle - Found Corner, and gives same witnesses as G.L.O. above.
- 1990: Survey by F. King - Found Railroad Spike in c/l E-W pavement in line with North and South Fences.

B. Description of corner evidence found and/or method applied in restoring or re-establishing corner:


- 1996: Found Railroad Spike in c/l of E-W pavement in line with North and South Fences - confirmed its location with the F. King Survey.

C. Description of monument for corner and accessories established to perpetuate locating the position of the corner:

- 1996: Replaced with Pavement Box containing 1/2" Road and Brass Cap to identify the Corner.

Referenced -

- North / Fence Post / 31.45'
- East / 6" Elm / 113.92'
- S30°E / 10" Apple / 95.40'
- S45°W / 14" Ash / 88.20'

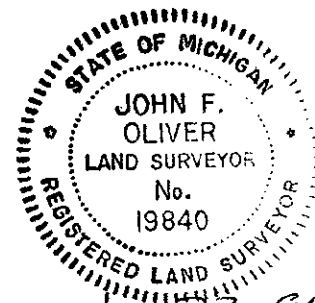

SIGNED BY _____ DATE 10-23-96

SURVEYOR'S MICHIGAN REGISTRATION NO. 19840 (SEAL)

FOR STATE AND UNITED STATES AGENCIES:

SIGNED BY _____ CHIEF OF SURVEY PARTY DATE _____

APPROVED AND SIGNED BY _____ MICHIGAN REGISTERED LAND SURVEYOR DATE _____ (SEAL)

SURVEYOR'S MICHIGAN REGISTRATION NO. _____