

**SURVEY & REMONUMENTATION**

DEC 16 1996

1996 ALCONA COUNTY REMONUMENTATION CORNER

**LAND CORNER RECORDATION CERTIFICATE**

FILING REQUIREMENT OF ACT 74, MICH. P.A. 1970

RECORDED

FOR CORNERS OF--:	LOCATED IN--:	CORNER CODE NUMBER
1. PUBLIC LAND SURVEY _____	T. 27N N. S., R. 5E E. W.	I-10
2. PROPERTY CONTROLLING IN SECTION _____	T. _____ N. S., R. _____ E. W.	_____
3. MISCELLANEOUS PROPERTY IN SECTION _____	T. _____ N. S., R. _____ E. W.	_____
4. LOT NO. _____, RECORDED PLAT _____		
5. PRIVATE CLAIMS _____		

Alcona County Remonumentation Liber Page 10

OCT 23 2 16 PM '96

*James A. Gauthier*  
REGISTRAR

APPROVED LAND CORNER  
P A 345 of 1990  
ALCONA COUNTY

Date 10-10-96

County Reg. E.J.L.  
REGISTERED DEEDS STAMP AND FILING NUMBER

I, John F. Oliver do hereby certify that under requirements of P.A. 74, Michigan P.A. of 1970, the corner points mentioned in lines 1 and 2 above (identified with circles on index code diagram-over) were, in a field survey on Sept. 27, 1996, established, re-established, monumented, re-monumented, recovered or restored as expressed below and in conformance with regulations and rules therefore as required in the current manual of survey instructions of the United States Department of the Interior, Bureau of Land Management or by a decree of a court of law. Furthermore, that the corner points mentioned in lines 3, 4 and 5 above were, in a field survey on \_\_\_\_\_ 19\_\_\_\_, found, recovered, restored, established or re-established as expressed below and in conformance with the rules of the Michigan State Board of Registration for Land Surveyors or, by a Decree of a Court of law:

A. Description of original monument and accessories and/or subsequent restoration:

- 1840: G.L.O. Survey by T. Patterson - Set Post and Referenced Hemlock 10 / N30°E / 13 - Hemlock 9 / S40°W / 12
- 1903: Sur. by Chapelle-Dark gray Boulder with Crockery and Glass under (entered in G.L.O. Notes)
- 1927: Sur. by Freer - Pine Stake 3X3 - Noted as orig. 1/4 Post
- 1953: MDOT constructs M-65 Highway - Places Pavement Box
- 1993: Survey by F. King - Found Iron in Pavement Box (no accessories given)

B. Description of corner evidence found and/or method applied in restoring or re-establishing corner:


- 1996: Found Iron in Pavement Box. Verified distances with MDOT Plans and F. King Survey.

C. Description of monument for corner and accessories established to perpetuate locating the position of the corner:

- 1996: Replaced Iron in Pavement Box with 1/2" Rod and Brass Cap marked to identify the Corner.

Referenced -

- N35°W / 14" Elm / 100.50'
- East / 17" Double Ash / 189.80'
- S60°E / Util. Pole / 84.21'
- S15°E / 13" Double Ash / 118.30'

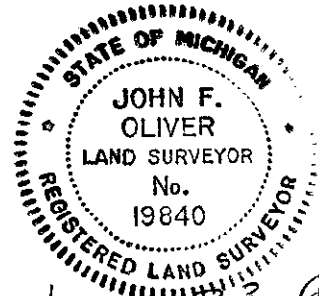

SIGNED BY *[Signature]* DATE 10-23-96

SURVEYOR'S MICHIGAN REGISTRATION NO. 19840 (SEAL)

FOR STATE AND UNITED STATES AGENCIES:

SIGNED BY \_\_\_\_\_ DATE \_\_\_\_\_  
CHIEF OF SURVEY PARTY

APPROVED AND SIGNED BY \_\_\_\_\_ DATE \_\_\_\_\_  
MICHIGAN REGISTERED LAND SURVEYOR (SEAL)

SURVEYOR'S MICHIGAN REGISTRATION NO. \_\_\_\_\_