

SURVEY A
REMONUMENTATION

1996 ALCONA COUNTY REMONUMENTATION CORNER

DEC 16 1996

LAND CORNER RECORDATION CERTIFICATE

COMMISSIONER

FILING REQUIREMENT OF ACT 74, MICH. P.A. 1996

RECORDED

| FOR CORNERS OF-- | LOCATED IN-- | CORNER CODE NUMBER |
|--------------------------------------|----------------------------------|--------------------|
| 1. PUBLIC LAND SURVEY | T. 27N. N. S., R. 5E. E. W. | J-9 |
| 2. PROPERTY CONTROLLING IN SECTION | , T. _____ N. S., R. _____ E. W. | _____ |
| 3. MISCELLANEOUS PROPERTY IN SECTION | , T. _____ N. S., R. _____ E. W. | _____ |
| 4. LOT NO. _____ | RECORDED PLAT _____ | _____ |
| 5. PRIVATE CLAIMS _____ | _____ | _____ |

Alcona County
Remonumentation
Liber / Page 128


OCT 23 2 15 PM '96

Jane A. Goodrich
REGISTERED CLERK
ALCONA COUNTY

APPROVED LAND CORNER
P A 345 of 1990
ALCONA COUNTY
Date 10-16-96
County Rep. E.T.L.
REGISTER OF DEEDS STAMP AND FILING NUMBER

I, John F. Oliver do hereby certify that under requirements of P.A. 74, Michigan P.A. of 1970, the corner points mentioned in lines 1 and 2 above (identified with circles on index code diagram--over) were, in a field survey on Sept. 27, 1996, established, re-established, monumented, re-monumented, recovered or restored as expressed below and in conformance with regulations and rules therefore as required in the current manual of survey instructions of the United States Department of the Interior, Bureau of Land Management or by a decree of a court of law. Furthermore, that the corner points mentioned in lines 3, 4 and 5 above were, in a field survey on _____ 19____, found, recovered, restored, established or re-established as expressed below and in conformance with the rules of the Michigan State Board of Registration for Land Surveyors or, by a Decree of a Court of law:

- A. Description of original monument and accessories and/or subsequent restoration:
- 1840: G.L.O. Survey by T. Patterson - Set Post and Referenced Cedar 13 / S61°E / 14 Hemlock 36 / N36°W / 30
 - 1916: Survey by A. Freer - Found Cedar Stake 4 X 4 - 4' long (no accessories given)
- B. Description of corner evidence found and/or method applied in restoring or re-establishing corner:
- 1996: No Corner found - Ownership of land North and South of this Corner is not to the N-S 1/4 Line - Corner was set by locating the 1/8 Line Fences to the East and West of the Corner and placing the Corner where it fit best in relation to the 1/8 Line Fences. Corner was placed on line between I-9 and K-9, 2678.45' East of I-9 and 2705.05' West of K-9.
- C. Description of monument for corner and accessories established to perpetuate locating the position of the corner:
- 1996: Placed Pavement Box containing a 1/2" Bar and Brass Cap marked to identify the Corner.
- Referenced -
- N30°E / 7" Cedar / 64.00'
 - N85°E / 8" W. Birch / 99.63'
 - S75°E / 5" Elm / 151.70'
 - S75°W / 7" Cedar / 101.65'

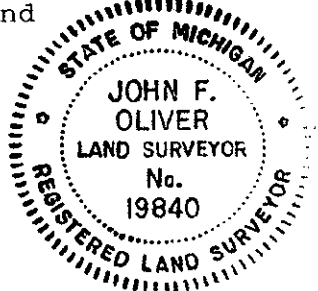

SIGNED BY [Signature] DATE 10-23-96
SURVEYOR'S MICHIGAN REGISTRATION NO. 19840 (SEAL)

FOR STATE AND UNITED STATES AGENCIES:
SIGNED BY _____ DATE _____
CHIEF OF SURVEY PARTY
APPROVED AND SIGNED BY _____ DATE _____
MICHIGAN REGISTERED LAND SURVEYOR (SEAL)