

1996 ALCONA COUNTY REMONUMENTATION CORNER

DEC 16 1996

LAND CORNER RECORDATION CERTIFICATE

COMMISSION FILING REQUIREMENT OF ACT 74, MICH. P.A. 1979 RECORDED

FOR CORNERS OF --:	LOCATED IN --:	CORNER CODE NUMBER
1. PUBLIC LAND SURVEY _____	T. 27N N. S., R. 5E E. W.	K-10
2. PROPERTY CONTROLLING IN SECTION _____	, T. _____ N. S., R. _____ E. W.	_____
3. MISCELLANEOUS PROPERTY IN SECTION _____	, T. _____ N. S., R. _____ E. W.	_____
4. LOT NO. _____, RECORDED PLAT _____		
5. PRIVATE CLAIMS _____		

Alcona County
Remonumentation
Page 9

OCT 23 2 16 PM '96

REGISTERED LAND SURVEYOR
ALCONA COUNTY MICHIGAN

APPROVED LAND CORNER
P A 345 of 1990
ALCONA COUNTY
Date 10-10-96
County Rep E.T.L.
REGISTER OF DEEDS STAMP AND FILING NUMBER

I, John F. Oliver do hereby certify that under requirements of P.A. 74, Michigan P.A. of 1970, the corner points mentioned in lines 1 and 2 above (identified with circles on index code diagram - over) were, in a field survey on Sept. 27, 1996, established, re-established, monumented, re-monumented, recovered or restored as expressed below and in conformance with regulations and rules therefore as required in the current manual of survey instructions of the United States Department of the Interior, Bureau of Land Management or by a decree of a court of law. Furthermore, that the corner points mentioned in lines 3, 4 and 5 above were, in a field survey on _____ 19____, found, recovered, restored, established or re-established as expressed below and in conformance with the rules of the Michigan State Board of Registration for Land Surveyors or, by a Decree of a Court of law:

A. Description of original monument and accessories and/or subsequent restoration:

- 1840: G.L.O. Survey by T. Patterson - Set Post and Referenced Hemlock 14 / N40°E / 32 - Sugar 6 / S50°W / 61
- 1901: Sur. by A. Freer-Cedar State-Stone 8X12 / S33°E / 66
- 1903: Sur. by E. Chapelle-8X13 Dark Gray Boulder-Glass & Crockery under
- 1904: Sur. by E. Chapelle-12X14 Dark Gray Boulder with + on top Glass and Crockery under
- 1981: Survey by C. Thomas-indicates NE Corner Sec. 26 on Survey no description of corner or accessories

B. Description of corner evidence found and/or method applied in restoring or re-establishing corner:


- 1996: Nothing found at Corner location - Set 1/2" Rod at centerline of Roads West, North, East and South.

C. Description of monument for corner and accessories established to perpetuate locating the position of the corner:

- 1996: Replaced with Pavement Box containing a 1/2" Rod and Brass Cap marked to identify the Corner.

Referenced -

- N47°E / 8" Apple / 104.20'
- N55°W / 11" Elm / 68.52'
- S15°W / 18" Double Elm / 135.15'
- S75°E / 8" Apple / 170.80'

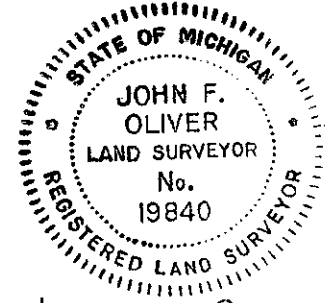

SIGNED BY *[Signature]* DATE 10-23-96
 SURVEYOR'S MICHIGAN REGISTRATION NO. 19840 (SEAL)

FOR STATE AND UNITED STATES AGENCIES:
 SIGNED BY _____ DATE _____
CHIEF OF SURVEY PARTY
 APPROVED AND SIGNED BY _____ DATE _____
MICHIGAN REGISTERED LAND SURVEYOR (SEAL)