

MAY 05 1997

1996 ALCONA COUNTY REMONUMENTATION CORNER

COMMISSION LAND CORNER RECORDATION CERTIFICATE

FILING REQUIREMENT OF ACT 74, MICH. P.A. 1970: RECORDED

Alcona County Remonumentation Liber 1996
 Oct 23 2 16 PM '96
 Janis A. Gaultier
 REGISTER OF DEEDS
 ALCONA COUNTY MICHIGAN
 APPROVED LAND CORNER
 P A 345 of 1990
 ALCONA COUNTY
 Date 10-10-96
 County Rep E.T.L.
 REGISTER OF DEEDS STAMP AND FILING NUMBER

FOR CORNERS OF --:	LOCATED IN --:	CORNER CODE NUMBER
1. PUBLIC LAND SURVEY	T. 27N N. S., R. 5E E. W.	K-11
2. PROPERTY CONTROLLING IN SECTION	, T. N. S., R. E. W.	
3. MISCELLANEOUS PROPERTY IN SECTION	, T. N. S., R. E. W.	
4. LOT NO. _____, RECORDED PLAT _____		
5. PRIVATE CLAIMS _____		


I, John F. Oliver do hereby certify that under requirements of P.A. 74, Michigan P.A. of 1970, the corner points mentioned in lines 1 and 2 above (identified with circles on index code diagram - over) were, in a field survey on Sept. 27, 1996, established, re-established, monumented, re-monumented, recovered or restored as expressed below and in conformance with regulations and rules therefore as required in the current manual of survey instructions of the United States Department of the Interior, Bureau of Land Management or by a decree of a court of law. Furthermore, that the corner points mentioned in lines 3, 4 and 5 above were, in a field survey on _____ 19____, found, recovered, restored, established or re-established as expressed below and in conformance with the rules of the Michigan State Board of Registration for Land Surveyors or, by a Decree of a Court of law:

- A. Description of original monument and accessories and/or subsequent restoration:
- 1840: G.L.O. Survey by T. Patterson - Set Post and Referenced Beech 11 / S51°E / 16 - Hemlock 6 / N40°W / 19
 - 1901: Sur. by A. Freer-Hemlock Stake-Hemlock 6 / N40°W / 19
 - Survey by E. Chapelle-date unknown-NBT-Beech 14 Stump / S19 1/2°W / 50
 - 1953: MDOT - Placed Pavement Box with construction of M-65 Highway
 - 1981: Sur. by C. Thomas-indicates SE Cor. S. 26-no desc. of cor.
 - 1994: Sur. by R. Mitchell-Fd. Pav't. Box-S36°E/36" Maple/80.12'-S11°W/36" Maple/89.26'-N22°W/14" Maple/117.80-N68°E/10"B. Oak/201.68
- B. Description of corner evidence found and/or method applied in restoring or re-establishing corner:
- 1996: Found Pavement Box with 1 1/2" Bar with all Four accessories given by R. Mitchell above except 10" B. Oak is an Elm.

C. Description of monument for corner and accessories established to perpetuate locating the position of the corner:

- 1996: Replaced 1 1/2" Bar with 1/2" Rod and Brass Cap marked to identify the Corner.

- Referenced -
- S36°E / 36" Maple / 80.30'
 - S11°W / 36" Maple / 89.20'
 - N22°W / 14" Maple / 118.00'
 - N68°E / 10" Elm / 201.80'

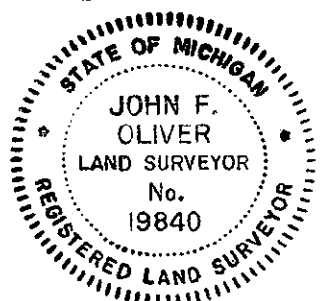

SIGNED BY [Signature] DATE 10-23-96

SURVEYOR'S MICHIGAN REGISTRATION NO. 19840 (SEAL)

FOR STATE AND UNITED STATES AGENCIES:
 SIGNED BY _____ DATE _____
 CHIEF OF SURVEY PARTY

APPROVED AND SIGNED BY _____ DATE _____
 MICHIGAN REGISTERED LAND SURVEYOR (SEAL)