

**SURVEY &
REMONUMENTATION**

FEB 07 2001

SECTION

2000 ALCONA COUNTY REMONUMENTATION CORNER

**LAND CORNER RECORDATION CERTIFICATE
Filing Requirement of Act 74, Mich. P.A. 1970**

For corners in

<u>Alcona</u> (County)	Located In:	Corner Code #
1. Public Land Survey	T 26NR7E	A-1, Millen Twp.
	T 27NR7E	A-13, Hawes Twp. ✓
	T 26NR6E	M-1, Millen Twp.
	T27NR6E	M-13, Mitchell Twp.
2. Property Controlling in Section	S ___ T ___ R ___	___
	S ___ T ___ R ___	___
3. Miscellaneous Property in Sec.	S ___ T ___ R ___	___
	S ___ T ___ R ___	___

Alcona County
Remonumentation
Liber 2 Page 78

Filed for Record in
ALCONA COUNTY MICHIGAN
DORIS A GAUTHIER
On 09-20-2000 At 09:42 am.
LAND CORNER 9.00

Register of Deeds Stamp & File Number

4. Lot No. _____, Recorded Plat _____
5. Private Claims _____

I, Thomas L. Fabis, in a field survey on Sept. 8, 2000 do hereby state that under requirements of P.A. 74, Michigan P.A. of 1970, the corner points mentioned in lines 1 and 2 above were in conformance with regulations and rules therefore as required in the current manual of survey instructions of the United States Department of the Interior, Bureau of Land Management or by a decree of a Court of Law and/or that the corner points mentioned in lines 3, 4 and 5 above were in conformance with the rules of the Michigan Board of Land Surveyors or by a Decree of a Court of Law; established, re-established, monumented, recovered, found as expressed below:

NOTE: Not more than 2 corners, all in the same town and range, may be recorded on this certificate.

T26N-R7E

	B	C	D	E	F	G	H	I	J	K	L	M
1	6	5	4	3	2	1						
2												
3												
4	7	8	9	10	11	12						
5												
6	16	17	16	15	14	13						
7												
8	19	20	21	22	23	24						
9												
10	30	29	28	27	26	25						
11												
12	31	32	33	34	35	36						
13												

A. Description of original monument and accessories and/or subsequent restoration:

- 1838: G.L.O. Survey Lewis Clason set post & referenced: Y. Pine 9 S29W 45, Cedar 8 N58E 10
- 1989: NELS Survey Liber 323 Page 984 John Oliver found 1/2" bar.
- 1998: NELS Survey Liber 326 Pages 859 & 860 Bill Woods measures to the corner.

B. Description of corner evidence found and/or method applied in restoring or reestablishing corner:

2000: Found 1/2" iron rod in the centerline of E-W (Bit. surface) Trask Lake Road, 2' East of centerline of gravel road to the North and 5' West of centerline of gravel road to the South. No existing witnesses.

The position of this corner is compatible with local surveys and is accepted as a careful and faithful perpetuation of the position of the original corner.


C. Description of monument for corner and accessories established to perpetuate locating the position of the corner:

- 2000: Set 3" dia. brass cap, stamped to identify the corner, over the existing 1/2" iron rod. Set Mon. Box over corner. Set tag #31591 in the following witnesses:
 - Fe. Cor. Post N30E 59.27
 - 7" Cedar S57E 62.45
 - 6" Twin Oak S30W 57.96
 - 8" W. Pine N31W 71.85

APPROVED LAND CORNER
P A 345 of 1990
ALCONA COUNTY
Date: 8-28-2000
County Rep. D. B. Gauthier

Signed by

Thomas L. Fabis

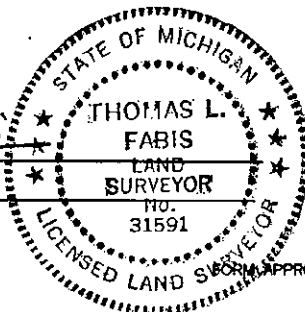

Date September 12, 2000

Surveyor's Michigan License No. 31591