

SURVEY & REMONUMENTATION

MAR 04 1998

SECTION

1997 Alcona County Remonumentation Corner
LAND CORNER RECORDATION CERTIFICATE
 Filing Requirement of Act 74, Mich. P.A. 1970

For corners in

Alcona
 (County)

Located In:	Corner Code #
T27N R 7E	C-12
T ___ R ___	_____
T ___ R ___	_____
T ___ R ___	_____
S ___ T ___ R ___	_____
S ___ T ___ R ___	_____
S ___ T ___ R ___	_____
S ___ T ___ R ___	_____

1. Public Land Survey


2. Property Controlling in Section

3. Miscellaneous Property in Sec.

4. Lot No. _____, Recorded Plat _____
 5. Private Claims _____

I, Daniel T. Kibbe, in a field survey on April 1, 1997 do hereby state that under requirements of P.A. 74, Michigan P.A. of 1970, the corner points mentioned in lines 1 and 2 above were in conformance with regulations and rules therefore as required in the current manual of survey instructions of the United States Department of the Interior, Bureau of Land Management or by a decree of a Court of Law and /or that the corner points mentioned in lines 3, 4 and 5 above were in conformance with the rules of the Michigan Board of Land Surveyors or by a Decree of a Court of Law; established, re-established, monumented, recovered, found as expressed below:

NOTE: Not more than 2 corners, all in the same town and range, may be recorded on this certificate.

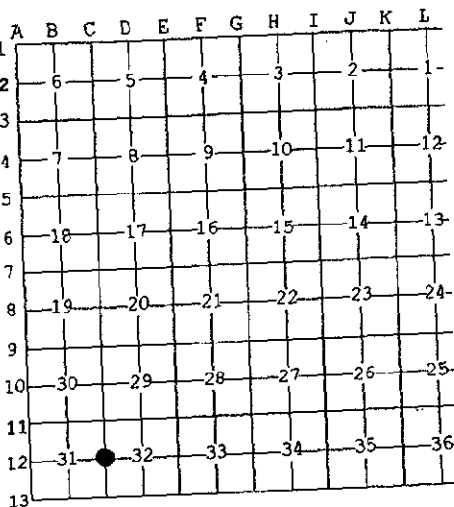

- A. Description of original monument and accessories and/or subsequent restoration:
- 1838: GLO Survey by Lewis Clason - set 1/4 Section post, referenced: W. Birch 14 - N 41 W - 10. Hem 6 - S 30 E - 15.
 - 1911: County survey by W.S. Freer - established 1/4 post stake WP 3 x 3, referenced: W. Pine Stump 24 - N76 W - 63.

- B. Description of corner evidence found and/or method applied in restoring or reestablishing corner:
- 1997: fd. 1/2" rebar 3' West of centerline of road on East-West fence lines.
- This corner position is compatible with county & local surveys. This corner position is accepted as a careful and faithful perpetuation of the position of the original corner.

- C. Description of monument for corner and accessories established to perpetuate locating the position of the corner:
- 1997: Placed 3" Alcona County cap stamped to identify the corner over 1/2" iron rod in monument box.
- Referenced:
- N87°W - 29.32' - wood post
 - S61°W - 94.19' - set tag over found P.K. nail in power pole.
 - N71°E - 33.97' - set tag in gate post
 - N52°E - 43.53' - set tag in gate post
 - East 33.0 - N.E.L.S. bar and cap

APPROVED LAND CORNER
 P A 345 of 1990
 ALCONA COUNTY
 Date 7/30/97
 County Rep. Doris A. Gauthier

RECORDED
 Date 10-31-97
 REMON LIBER 1 PAGE 27
 Time 3:30 P M
Doris A. Gauthier
 Doris A. Gauthier
 REGISTER OF DEEDS

Register of Deeds Stamp & File Number

Signed by Daniel T. Kibbe
 Surveyor's Michigan License No. 37278

Date October 22, 1997

