

SURVEY & REMONUMENTATION

FEB 07 2001

SECTION

2000 ALCONA COUNTY REMONUMENTATION CORNER LAND CORNER RECORDATION CERTIFICATE Filing Requirement of Act 74, Mich. P.A. 1970

For corners in

Alcona <small>(County)</small>	Located In:	Corner Code #
1. Public Land Survey	T26NR7E	C-1, Millen Twp.
	T27NR7E	C-13, Hawes Twp. ✓
	T___R___	_____
	T___R___	_____
2. Property Controlling in Section	S___T___R___	_____
	S___T___R___	_____
3. Miscellaneous Property in Sec.	S___T___R___	_____
	S___T___R___	_____
4. Lot No. _____, Recorded Plat _____		
5. Private Claims _____		

Alcona County
Remonumentation
Liber 2 Page 80

Filed for Record in
ALCONA COUNTY MICHIGAN
DORIS A GAUTHIER
On 09-20-2000 At 09:42 am.
LAND CORNER 9.00

Register of Deeds Stamp & File Number

T26N-R7E

	A	B	C	D	E	F	G	H	I	J	K	L	M
1			●										
2	6		5		4		3		2		1		
3													
4	7		8		9		10		11		12		
5													
6	10		17		16		15		14		13		
7													
8	19		20		21		22		23		24		
9													
10	30		29		28		27		26		25		
11													
12	31		32		33		34		35		36		
13													

I, Thomas L. Fabis, in a field survey on Sept. 8, 2000 do hereby state that under requirements of P.A. 74, Michigan P.A. of 1970, the corner points mentioned in lines 1 and 2 above were in conformance with regulations and rules therefore as required in the current manual of survey instructions of the United States Department of the Interior, Bureau of Land Management or by a decree of a Court of Law and/or that the corner points mentioned in lines 3, 4 and 5 above were in conformance with the rules of the Michigan Board of Land Surveyors or by a Decree of a Court of Law; established, re-established, monumented, recovered, found as expressed below:

NOTE: Not more than 2 corners, all in the same town and range, may be recorded on this certificate.

A. Description of original monument and accessories and/or subsequent restoration:

- 1838: G.L.O. Survey Lewis Clason set post & referenced: W. Pine 22 N67E 30, do 18 N34W 26
- 1838: G.L.O. Survey Lewis Clason intersected N. Boundary at Post & referenced: beech 12 S42W 34, Y. Pine 18 S22E 20
- 1965: Co. Hwy. Plans set R.R. Spike and referenced.
- 1994: Survey Liber 281 Page 633 Duane MacNeill found Boat Spike.
- 1998: Computer Notes John Oliver found R.R. Spike.

B. Description of corner evidence found and/or method applied in restoring or reestablishing corner:

- 2000: Found R.R. Spike at intersection of E-W (Bit. surface) Trask Lake Road with (Bit. surface) N-S Stout Road. No existing witnesses.

The position of this corner is compatible with local surveys and is accepted as a careful and faithful perpetuation of the position of the original corner.

C. Description of monument for corner and accessories established to perpetuate locating the position of the corner:


- 2000: Removed R.R. Spike and set 1/2"x24" iron rod capped with a 3" dia. brass cap, stamped to identify the corner. A Mon. Box was installed over the corner. Set tag #31591 in the following witnesses:
 P. Pole N30W 88.08
 Fe. Post S36E 51.82
 3" Elm S68W 97.40
 7" Elm S22E 98.54

APPROVED LAND CORNER
P A 345 of 1990
ALCONA COUNTY
Date 8-28-2000
County Rep. [Signature]

Signed by

Thomas L. Fabis

Surveyor's Michigan License No. 31591

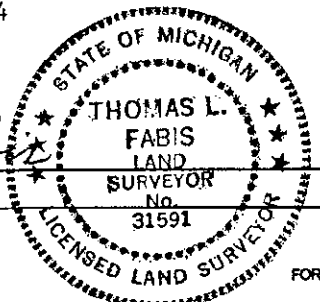

Date September 12, 2000