

**SURVEY & REMONUMENTATION**

MAR 04 1998

**SECTION**

1997 ALCONA COUNTY REMONUMENTATION CORNER

**LAND CORNER RECORDATION CERTIFICATE**  
Filing Requirement of Act 74, Mich. P.A. 1970

Alcona County Remonumentation  
Liber 1 Page 243

For corners in Alcona (County) Located In: Corner Code #


1. Public Land Survey	T <u>27N</u> R <u>7E</u>	<u>I-3</u>
	T _____ R _____	<u>Hawes Twp.</u>
	T _____ R _____	_____
	T _____ R _____	_____
2. Property Controlling in Section	S _____ T _____ R _____	_____
	S _____ T _____ R _____	_____
3. Miscellaneous Property in Section	S _____ T _____ R _____	_____
	S _____ T _____ R _____	_____

APPROVED LAND CORNER  
P.A. 345 of 1990  
ALCONA COUNTY  
Date 8/15/97  
County Rep. [Signature]

RECORDED  
August 25 1:00 P.M. 97

[Signature]  
REGISTER OF DEEDS  
Register of Deeds Stamp & File Number

4. Lot No. \_\_\_\_\_, Recorded Plat \_\_\_\_\_  
5. Private Claims \_\_\_\_\_

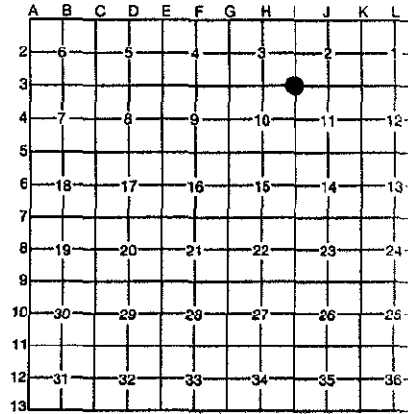

I, Thomas L. Fabis, in a field survey on June 12, 1997, do hereby certify that under requirements of P.A. 74, Michigan P.A. of 1970, the corner points mentioned in lines 1 and 2 above were in conformance with regulations and rules therefore as required in the current manual of survey instructions of the United States Department of the Interior, Bureau of Land Management or by a decree of a Court of Law and/or that the corner points mentioned in lines 3, 4 and 5 above were in conformance with the rules of the Michigan Board of Professional Surveyors or by a Decree of a Court of Law; established, re-established, monumented, re-monumented, recovered, found as expressed below:


**NOTE: Not more than 4 corners, all in the same town and range, may be recorded on this certificate.**

- A. Description of original monument and accessories and/or subsequent restoration:**
- 1840: G.L.O. Survey Thomas Pattison Set post & referenced: Cedar 12 N16E 14, Do 10 S52W 11.
  - 1970: Survey Liber 156 Page 752 James Scott Set Conc. Mon.
  - 1990: L.C.R.C. Liber 1 Page 424 Thomas Fabis Found 4" dia. Conc. Mon. & referenced: (5" W. Birch S54W 8.5, 5" Spruce S56E 16.83, 6" Tamarack N30E 31.1', 7" Cedar N8E 34.5)
  - 1994: MDNR Survey Proj. No. 27-94008 - Carl Johnson - Found conc. mon.

- B. Description of corner evidence found and/or method applied in restoring or reestablishing corner:**
- 1997: Found Conc. Mon. and all four blazed witnesses mentioned in 1990 L.C.R.C. Liber 1 Page 424.

This corner is accepted as a careful and faithful perpetuation of the position of the original corner.

- C. Description of monument for corner and accessories established to perpetuate locating the position of the corner:**
- 1997: Set 3" dia. aluminum cap, stamped to identify the corner, over the existing 4" dia. concrete monument.
  - Existing tag P.S. #31591 can be found in the following witnesses:
    - 5" W. Birch - S54W - 8.38'
    - 6" Spruce - S56E - 16.81'
    - 7" Tamarack - N30W - 31.11'
    - 8" Cedar - N08E - 34.50'

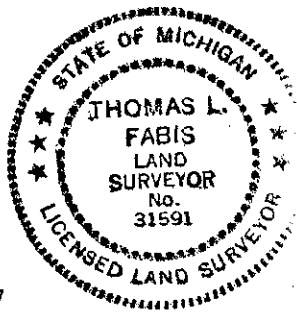

Signed by Thomas L. Fabis  
Surveyor's Michigan License No. 31591

Date August 15, 1997