

SURVEY & REMONUMENTATION

MAR 04 1998

1997 ALCONA COUNTY REMONUMENTATION CORNER

Alcona County
Remonumentation
Liber 1 Page 244

LAND CORNER RECORDATION CERTIFICATE
Filing Requirement of Act 74, Mich. P.A. 1970

SECTION
For corners in
Alcona
(County)

Located in: _____ Corner Code # _____


- | | | | | | |
|--------------------------------------|---|------------|---|-----------|------------|
| 1. Public Land Survey | T | <u>27N</u> | R | <u>7E</u> | K-3 |
| | T | _____ | R | _____ | Hawes Twp. |
| | T | _____ | R | _____ | _____ |
| | T | _____ | R | _____ | _____ |
| 2. Property Controlling in Section | S | _____ | T | _____ | _____ |
| | S | _____ | T | _____ | _____ |
| 3. Miscellaneous Property in Section | S | _____ | T | _____ | _____ |
| | S | _____ | T | _____ | _____ |

APPROVED LAND CORNER
P.A. 345 of 1990
ALCONA COUNTY
Date 8/15/97
County Rep [Signature]

RECORDED
August 25 11:00 P.M. 97

[Signature]
REGISTER OF DEEDS
Register of Deeds Stamp & File Number

4. Lot No. _____, Recorded Plat _____
5. Private Claims _____

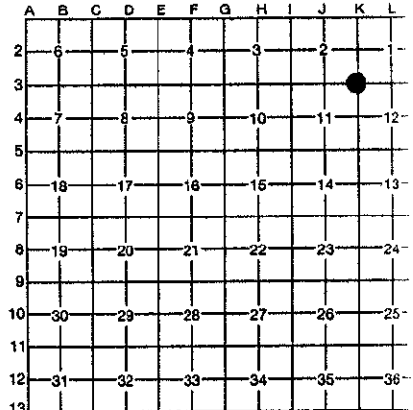

I, Thomas L. Fabis, in a field survey on June 12, 1997, do hereby certify that under requirements of P.A. 74, Michigan P.A. of 1970, the corner points mentioned in lines 1 and 2 above were in conformance with regulations and rules therefore as required in the current manual of survey instructions of the United States Department of the Interior, Bureau of Land Management or by a decree of a Court of Law and/or that the corner points mentioned in lines 3, 4 and 5 above were in conformance with the rules of the Michigan Board of Professional Surveyors or by a Decree of a Court of Law; established, re-established, monumented, re-monumented, recovered, found as expressed below:

NOTE: Not more than 4 corners, all in the same town and range, may be recorded on this certificate.

A. Description of original monument and accessories and/or subsequent restoration:

- 1840: G.L.O. Survey Thomas Pattison Set post: Y. Pine 30 in for post
- 1907: County Survey W. Pine Stump & referenced.
- 1935: Supers Plat of Backus Beach (L.1 P.75) Jos. McNeil Uses corner.
- 1935: First Add. to Backus Beach Plat (L.1 P.77) Jos. McNeil Uses corner.
- 1974: Survey Ed LaCross Found 6" Sq. Mon. & referenced.
- 1976: Survey L.162 P.647 Duane MacNeill Found 8" x 8" Conc. Mon. & referenced.
- 1979: Survey W.O. 1-1131 David Guthrie Found Conc. Mon. & referenced.
- 1982: Survey L. 187 P. 277 John Oliver Found Conc. Mon.
- 1983 & 1985: Surveys L.218 P.577 & L.218 P.690 Duane MacNeill Found 6" x 6" Conc. Mon.
- 1994: Survey W.O. 1-306 Earl Lewis Found 6" Sq. Conc. Mon. & referenced.

B. Description of corner evidence found and/or method applied in restoring or reestablishing corner:

- 1997: Found 6" x 6" Conc. Mon. and all four witnesses by Earl Lewis.


The position of this corner is compatible with county and local surveys and is accepted as a careful and faithful perpetuation of the position of the original corner.

C. Description of monument for corner and accessories established to perpetuate locating the position of the corner:

- 1997: Set 3" dia. aluminum cap, stamped to identify the corner, over the existing 6" x 6" conc. monument.

Existing nails are in the following witnesses:

- 7" Oak - N20E - 29.05'
- 4" Oak - N70E - 19.43'
- 10" Oak - S37E - 27.05'
- 8" Twin Oak - S10E - 28.43'

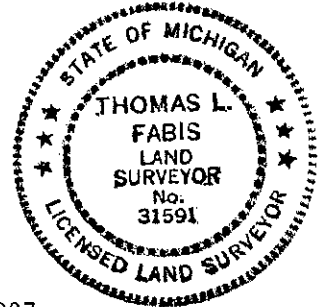

Signed by Thomas L. Fabis

Date August 15, 1997

Surveyor's Michigan License No. 31591