

**SURVEY &  
REMONUMENTATION**

**MAR 04 1998**

**SECTION**

1997 Alcona County Remonumentation Corner  
**LAND CORNER RECORDATION CERTIFICATE**  
Filing Requirement of Act 74, Mich. P.A. 1970

For corners in

<u>Alcona</u> (County)	Located In:	Corner Code #
1. Public Land Survey	T <u>27</u> NR <u>7E</u>	<u>K-13</u>
	T ___ R ___	_____
	T ___ R ___	_____
	T ___ R ___	_____
2. Property Controlling in Section	S ___ T ___ R ___	_____
	S ___ T ___ R ___	_____
3. Miscellaneous Property in Sec.	S ___ T ___ R ___	_____
	S ___ T ___ R ___	_____

**APPROVED LAND CORNER**  
P.A. 345 of 1990  
**ALCONA COUNTY**

Date 7/30/97  
County Rep. [Signature]

**RECORDED**  
Date 10-31-1997

REMON LIBER. 1 PAGE 278  
Time 3:30 PM

[Signature]  
**Chris A. Gauthier**  
REGISTER OF DEEDS

Register of Deeds Stamp & File Number

4. Lot No. \_\_\_\_\_, Recorded Plat \_\_\_\_\_  
5. Private Claims \_\_\_\_\_

I, Daniel T. Kibbe, in a field survey on June 11, 1997 do hereby state that under requirements of P.A. 74, Michigan P.A. of 1970, the corner points mentioned in lines 1 and 2 above were in conformance with regulations and rules therefore as required in the current manual of survey instructions of the United States Department of the Interior, Bureau of Land Management or by a decree of a Court of Law and /or that the corner points mentioned in lines 3, 4 and 5 above were in conformance with the rules of the Michigan Board of Land Surveyors or by a Decree of a Court of Law; established, re-established, monumented, recovered, found as expressed below:

NOTE: Not more than 2 corners, all in the same town and range, may be recorded on this certificate.

A	B	C	D	E	F	G	H	I	J	K	L	M
1												
2	6		5		4		3		2		1	
3												
4	7		8		9		10		11		12	
5												
6	18		17		16		15		14		13	
7												
8	19		20		21		22		23		24	
9												
10	30		29		28		27		26		25	
11												
12	31		32		33		34		35		36	
13												

A. Description of original monument and accessories and/or subsequent restoration:

1838: GLO Survey by Lewis Clason - Set post, referenced: Spr. Pine 9-N44E-22 / Spr. Pine 7-N45W-09.


B. Description of corner evidence found and/or method applied in restoring or reestablishing corner:

1997: Found N.E.L.S. bar & cap 3.5' North of Q of road. Found Forest Service location on 18" oak indicating that the Southwest corner of Section 36 was 42.2' North. This corner position is accepted as a careful and faithful perpetuation of the position of the original corner.

C. Description of monument for corner and accessories established to perpetuate locating the position of the corner:

1997: Placed 3" Alcona County cap stamped to identify the corner over 1/2" iron rod in monument box.

Referenced:  
South-42.3'-Found spike in 18" oak with U.S.F.S. location poster  
S20W-38.04'-Found spike in 8" red pine  
North-22.29'-Found spike in 5" oak  
S57W-54.96'-Set tag in 10" red pine  
N70W-95.00'-Set tag in 21" oak

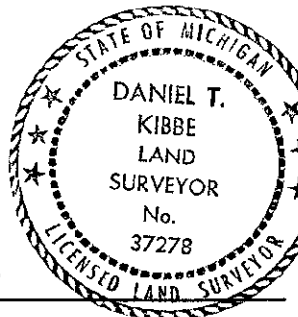

Signed by [Signature]  
Surveyor's Michigan License No. 37278

Date October 22, 1997