

SURVEY & REMONUMENTATION

MAR 04 1998

1997 ALCONA COUNTY REMONUMENTATION CORNER

Alcona County Remonumentation Liber 1 Page 246

SECTION

LAND CORNER RECORDATION CERTIFICATE
Filing Requirement of Act 74, Mich. P.A. 1970


RECORDED August 25, 1:00 P.M. 97

For corners in <u>Alcona</u> (County)	Located In:	Corner Code #
1. Public Land Survey	T <u>27N</u> R <u>7E</u>	<u>L-3</u>
	T _____ R _____	<u>Hawes Twp.</u>
	T _____ R _____	_____
	T _____ R _____	_____
2. Property Controlling in Section	S _____ T _____ R _____	_____
	S _____ T _____ R _____	_____
3. Miscellaneous Property in Section	S _____ T _____ R _____	_____
	S _____ T _____ R _____	_____

APPROVED LAND CORNER
P.A. 345 of 1990
ALCONA COUNTY
Date 8/17/97
County Rep. [Signature]

[Signature]
REGISTER OF DEEDS
Register of Deeds Stamp & File Number

4. Lot No. _____, Recorded Plat _____
5. Private Claims _____

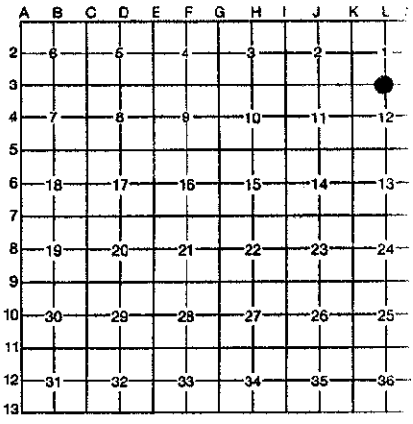

I, Thomas L. Fabis, in a field survey on June 12, 19 97, do hereby certify that under requirements of P.A. 74, Michigan P.A. of 1970, the corner points mentioned in lines 1 and 2 above were in conformance with regulations and rules therefore as required in the current manual of survey instructions of the United States Department of the Interior, Bureau of Land Management or by a decree of a Court of Law and/or that the corner points mentioned in lines 3, 4 and 5 above were in conformance with the rules of the Michigan Board of Professional Surveyors or by a Decree of a Court of Law; established, re-established, monumented, re-monumented, recovered, found as expressed below:

NOTE: Not more than 4 corners, all in the same town and range, may be recorded on this certificate.

- A. Description of original monument and accessories and/or subsequent restoration:**
 1840: G.L.O. Survey Thomas Pattison. Set post & referenced: Y. Pine 12 S47W 26, do 9 N55E 28
 1907: County Survey - Iron Bolt 1" Square
 1970: Mt. Maria Hills Plat (L.2 P.92)-Feldhauser Assoc. - Uses corner.
 1972: Survey L.165 P.222 - James Scott - Uses corner.
 1976: Survey L.162 P.236 & L.C.R.C. - John Oliver - Set 1/2" Bar & Cap & referenced.
 1979: Surveys W.O. 1-1131 & W.O. 1-1237 - David Guthrie - Exis. 1/2" iron rod & referenced.
 1979: Survey L.178 P.491 - Duane MacNeill - Uses corner
 1982: Survey L187 P.277 - John Oliver - Uses corner
 1986: Surveys L.218 P's.573 & 575 - Duane MacNeill - Uses corner.

- B. Description of corner evidence found and/or method applied in restoring or reestablishing corner:**
 1997: Found 1/2" iron rod & cap (unknown) and the following witnesses:
 Conc. Mon. N5W 35.10, Tag #22435 P. Pole N28E 36.66',
 8" Oak S22E 54.28', which match the John Oliver and David Guthrie Surveys.

The position of this corner is compatible with county and local surveys and is accepted as a careful and faithful perpetuation of the position of the original corner.

- C. Description of monument for corner and accessories established to perpetuate locating the position of the corner:**
 1997: Set 3" dia. Brass cap, stamped to identify the corner over the existing 1/2" iron rod and set a Monument Box around the corner.
 References:
 Conc. Mon. - N5W - 35.10'
 Tag #22435 in P. Pole - N28E - 36.66'
 Existing tag in 8" Oak - S22E - 54.28'
 Set tag #31591 in 9" W. Pine - S63E - 68.61'



Signed by Thomas L. Fabis Date August 15, 1997
 Surveyor's Michigan License No. 31591