

SURVEY & REMONUMENTATION

MAR 04 1998

1997 ALCONA COUNTY REMONUMENTATION CORNER

Alcona County Remonumentation Liber 1 Page 247


LAND CORNER RECORDATION CERTIFICATE

Filing Requirement of Act 74, Mich. P.A. 1970

SECTION
For corners in Alcona
(County)

Located In: Corner Code #

- | | | | | |
|--------------------------------------|---|------------|---|-----------|
| 1. Public Land Survey | T | <u>27N</u> | R | <u>7E</u> |
| | T | | R | |
| | T | | R | |
| | T | <u>27N</u> | R | <u>8E</u> |
| 2. Property Controlling in Section | S | | T | |
| | S | | T | |
| 3. Miscellaneous Property in Section | S | | T | |
| | S | | T | |

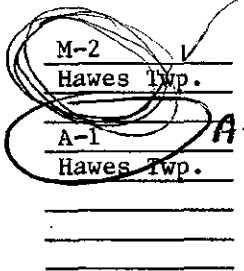

APPROVED LAND CORNER
P.A. 345 of 1997
ALCONA COUNTY
Date 8/15/97
County Rep. [Signature]

RECORDED
August 25 1:00 P.M. 97

[Signature]
REGISTER OF DEEDS

Register of Deeds Stamp & File Number

4. Lot No. _____, Recorded Plat _____
5. Private Claims _____

A	B	C	D	E	F	G	H	I	J	K	L
2	6	5	4	3	2	1					
3											
4	7	6	5	4	3	2	1				
5											
6	18	17	16	15	14	13					
7											
8	18	20	21	22	23	24					
9											
10	30	29	28	27	26	25					
11											
12	31	32	33	34	35	36					
13											

I, Thomas L. Fabis, in a field survey on June 12, 1997 do hereby certify that under requirements of P.A. 74, Michigan P.A. of 1970, the corner points mentioned in lines 1 and 2 above were in conformance with regulations and rules therefore as required in the current manual of survey instructions of the United States Department of the Interior, Bureau of Land Management or by a decree of a Court of Law and/or that the corner points mentioned in lines 3, 4 and 5 above were in conformance with the rules of the Michigan Board of Professional Surveyors or by a Decree of a Court of Law; established, re-established, monumented, re-monumented, recovered, found as expressed below:

NOTE: Not more than 4 corners, all in the same town and range, may be recorded on this certificate.

A. Description of original monument and accessories and/or subsequent restoration:

- 1838: G.L.O. Survey Lewis Clason Set post & referenced: (Y. Pine 26 S48W 61, do 22 N62W 13).
- 1973: Survey Liber 151 Page 251 James Scott Found ex. pipe.
- 1979: Surveys L.173 P's. 965 & 966, and L. 173 P. 968 Duane MacNeill Found 1" Pipe and referenced: N75W 34.73 P.P., N05E 14.68 P.P., N80E 23.17 8" Maple.

B. Description of corner evidence found and/or method applied in restoring or reestablishing corner:

- 1997: Found 1" Pipe and three existing witnesses: exis. shiner in P.P. N70W 34.60', exis. shiner in Anchor Pole N10E 14.60', 12" Maple N75E 23.10'. Matching the surveys by Duane MacNeill. Distance to M-1, T27N, R7E is compatible with the James Scott Survey and Duane MacNeill Surveys.


This corner is accepted as a careful and faithful perpetuation of the position of the original corner.

C. Description of monument for corner and accessories established to perpetuate locating the position of the corner:

- 1997: Set 1/2" iron rod with 3" dia. alum. cap, stamped to identify the corner inside the existing 1" Pipe, 31 feet East of Power Line.

References:

- Exis. shiner in P.P. - N70W - 34.60'
- Exis. shiner in Anchor Pole - N10E - 14.60'
- Set tag #31591 in 12" Maple - N75E - 23.10'
- Set tag #31591 in 5" Oak - S60E - 25.45'

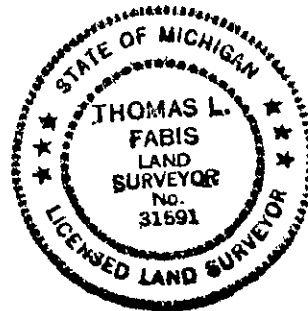

Signed by Thomas L. Fabis

Date August 15, 1997

Surveyor's Michigan License No. 31591