

# SURVEY & REMONUMENTATION

MAR 04 1998

1997 Alcona County Remonumentation Corner  
**LAND CORNER RECORDATION CERTIFICATE**  
 Filing Requirement of Act 74, Mich. P.A. 1970

APPROVED LAND CORNER  
 P A 345 of 1990  
 ALCONA COUNTY

SECTION  
 For corners in

<u>Alcona</u> (County)	Located in:	Corner Code #	
1. Public Land Survey	T27N R 7E	<u>M-9</u>	
	T27N R 8E	<u>A-9</u>	
	T ___ R ___	___	___
	T ___ R ___	___	___
2. Property Controlling in Section	S ___ T ___ R ___	___	___
	S ___ T ___ R ___	___	___
3. Miscellaneous Property in Sec.	S ___ T ___ R ___	___	___
	S ___ T ___ R ___	___	___

Date 7/30/97  
 County Rep. D. B. [Signature]

RECORDED  
 Date 10-31-1997  
 REMON LIBER 1 PAGE 273  
 Time 3:30 PM  
Doris A. Gauthier  
 Doris A. Gauthier  
 REGISTER OF DEEDS

Register of Deeds Stamp & File Number

4. Lot No. \_\_\_\_\_, Recorded Plat \_\_\_\_\_  
 5. Private Claims \_\_\_\_\_

I, Daniel T. Kibbe, in a field survey on April 1, 1997 do hereby state that under requirements of P.A. 74, Michigan P.A. of 1970, the corner points mentioned in lines 1 and 2 above were in conformance with regulations and rules therefore as required in the current manual of survey instructions of the United States Department of the Interior, Bureau of Land Management or by a decree of a Court of Law and/or that the corner points mentioned in lines 3, 4 and 5 above were in conformance with the rules of the Michigan Board of Land Surveyors or by a Decree of a Court of Law; established, re-established, monumented, recovered, found as expressed below.

NOTE: Not more than 2 corners, all in the same town and range, may be recorded on this certificate.

	A	B	C	D	E	F	G	H	I	J	K	L	M
1													
2	6		5		4		3		2		1		
3													
4	7		8		9		10		11		12		
5													
6	18		17		16		15		14		13		
7													
8	19		20		21		22		23		24		
9													
10	30		29		28		27		26		25		
11													
12	31		32		33		34		35		36		
13													

A. Description of original monument and accessories and/or subsequent restoration:

- 1838: GLO survey by Lewis Clason - set post, referenced: Y, Pine 11 - S 66 W - 7 / Y. Pine 22 - S 64 W - 16.
- 1914: County Survey by Andrew J. Freer - fd. gray boulder 20 x 16 9 "X" on top w/ broken glass.
- 1916: County Survey by Andrew J. Freer - fd. gray boulder 9 x 16 x 2 "X" on top w/ glass.
- 1976: L.C.R.C. - fd. 1" bar, referenced N 32 W - 76.61' P. Pole / N 84 W - 57.05' 1 1/2" pipe / S 86 E - 52.36' P. Pole.
- 1977: Survey by D.R. MacNeil - fd. corner, referenced: East 52.33' P. Pole / West 34.97' fence post / N 45 W 75.56' P. Pole.


B. Description of corner evidence found and/or method applied in restoring or reestablishing corner:

- 1997: Found PK nail over 1 1/2" boat spike.

This corner position is compatible with county & local surveys. This corner position is accepted as a careful and faithful perpetuation of the position of the original corner.

C. Description of monument for corner and accessories established to perpetuate locating the position of the corner:

- 1997: Placed 3" Alcona County cap stamped to identify the corner of 1/2" iron rod in monument box.  
 Referenced:  
 N59°E - 39.20' - fd. tag #15410 in 10" Poplar  
 S54°W - 105.50' - fd. tag #15410 in 16" Oak  
 N29°W - 76.48' - fd. tag #15410 in Power Pole  
 S81°E - 52.32' - fd. tag #15410 in Power Pole

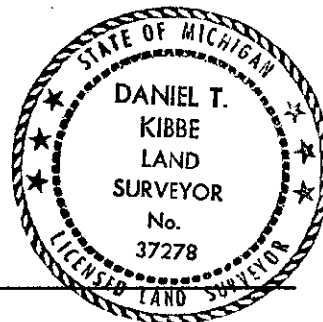

Signed by [Signature]  
 Surveyor's Michigan License No. 37278

Date October 22, 1997