

2091-07

1993 Alcona County Remonumentation Corner

LAND CORNER RECORDATION CERTIFICATE

RECORDED

Filing Requirement of Act 74, Mich. P.A. 1970 Monum Liber 1 Page 7

For corners in

Alcona (County)

Located In:

Corner Code #

- 1. Public Land Survey T 27N R 7E M-12 (E 1/4, 36) (Hawes Twp.)
2. Property Controlling in Section S T R
3. Miscellaneous Property in Sec. S T R

Dec 17 1 45 PM '93

Signature of Dennis A. Bantier, Register of Deeds, Alcona County, Michigan

Register of Deeds Stamp & File Number

- 4. Lot No. , Recorded Plat
5. Private Claims

Grid table with columns A-M and rows 2-13, containing numbers 1-36.

I, Thomas L. Fabis, in a field survey on November 19, 1993 do hereby certify that under requirements of P.A. 74, Michigan P.A. of 1970, the corner points mentioned in lines 1 and 2 above were in conformance with regulations and rules therefore as required in the current manual of survey instructions of the United States Department of the Interior, Bureau of Land Management or by a decree of a Court of Law and/or that the corner points mentioned in lines 3, 4 and 5 above were in conformance with the rules of the Michigan Board of Land Surveyors or by a Decree of a Court of Law; established, re-established, monumented, re-monumented, recovered, found as expressed below:

NOTE: Not more than 4 corners, all in the same town and range, may be recorded on this certificate.

A. Description of original monument and accessories and/or subsequent restoration:

- 1838: G.L.O. Survey by Lewis Clason - Set post (B. Oak 14 S45W 51, Y. Pine 28 N31W 26)
1976: L.C.R.C. Liber 1 Page 44 by John Oliver - Found P.K. nail, reset R.R. Spike and established 3 witnesses (East - Conc. Mon. - 33.20', West - Conc. Mon. - 33.10' and S48°E - 6" Oak - 42.4')

B. Description of corner evidence found and/or method applied in restoring or reestablishing corner:

- 1993: Found R.R. Spike and 3 witnesses as per L.C.R.C. Liber 1 Page 44 and is accepted as a careful and faithful perpetuation of the position of the original corner.


SURVEY & REMONUMENTATION

1993

COMMISSION

C. Description of monument for corner and accessories established to perpetuate locating the position of the corner:

- 1993: Removed existing corner material and set 5/8" iron rod with brass cap in Mon. Box during a Road Improvement Project for Alcona County Road Commission. Reestablished witnesses are:
Set tag #31591 in 9" Oak - N80°E - 35.23'
Set tag #31591 in 8" Oak - S50°E - 42.40'
Conc. Mon. - East - 33.20'
Conc. Mon. - West - 33.13'

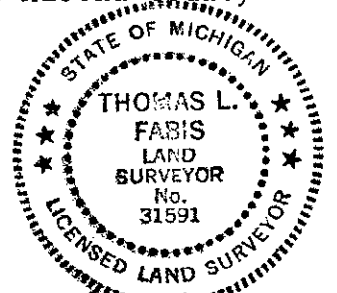

Signed by Thomas L. Fabis
Surveyor's Michigan License No. 31591

Date November 24, 1993