

SURVEY & REMONUMENTATION

MAR 04 1998

SECTION

1997 Alcona County Remonumentation Corner LAND CORNER RECORDATION CERTIFICATE
Filing Requirement of Act 74, Mich. P.A. 1970

APPROVED LAND CORNER
P A 345 of 1990
ALCONA COUNTY

For corners in

Alcona

(County)

Located In:

Corner Code #

1. Public Land Survey

T 27NR 8E A-13
T 27NR 7E M-13
T 26N R 7E M-1
T 26N R 8E A-1

2. Property Controlling in Section

S ___ T ___ R ___
S ___ T ___ R ___
S ___ T ___ R ___
S ___ T ___ R ___

3. Miscellaneous Property in Sec.

4. Lot No. _____, Recorded Plat _____
5. Private Claims _____

Date 7/30/97
County Rep. D. B. Con

RECORDED
Date 10-31-1997
REMON LIBER 1 PAGE 280

Time 3:30 M
Doris A. Gauthier
Doris A. Gauthier
REGISTER OF DEEDS

Register of Deeds Stamp & File Number

I, Daniel T. Kibbe, in a field survey on April 1, 1997 do hereby state that under requirements of P.A. 74, Michigan P.A. of 1970, the corner points mentioned in lines 1 and 2 above were in conformance with regulations and rules therefore as required in the current manual of survey instructions of the United States Department of the Interior, Bureau of Land Management or by a decree of a Court of Law and for that the corner points mentioned in lines 3, 4 and 5 above were in conformance with the rules of the Michigan Board of Land Surveyors or by a Decree of a Court of Law; established, re-established, monumented, recovered, found as expressed below:

NOTE: Not more than 2 corners, all in the same town and range, may be recorded on this certificate.

A	B	C	D	E	F	G	H	I	J	K	L
1											
2	6	5	4	3	2	1					
3											
4	7	8	9	10	11	12					
5											
6	18	17	16	15	14	13					
7											
8	19	20	21	22	23	24					
9											
10	30	29	28	27	26	25					
11											
12	31	32	33	34	35	36					
13											

A. Description of original monument and accessories and/or subsequent restoration:

- 1838: GLO Survey by Lewis Clason - Set post, referenced: Y. Pine 20-S34W-38 / Y. Pine 16-N65E-4
- 1954: Survey by Robert S. Scott - visited corner.
- 1956: Road alignment notes R.S. Scott - Fd. 1" iron pipe, referenced: West-33'-con. mon./ N85W-67.8'-16" Oak / N75E-42.6'-14" Oak / East-33-con. mon.
- 1956: Recorded corner by Norman C. Caldwell - Set 1" iron pipe from R.S. scott notes.
- 1976: Survey by David Guthrie - Fd. R.R. spike.
- 1988: Survey and L.C.R.C. by Robert F. Mitchell - Set Con. Mon. w/brass cap, referenced: N81E-18" R Oak - 42.83' / S12E-14" Tpl. R. Oak - 118.46' / S36W-10" Dle R. Oak - 146.55' / N42W-14" Tpl. W. Oak - 112.74'.

B. Description of corner evidence found and/or method applied in restoring or reestablishing corner:


1997: Found concrete monument with brass cap

This corner position is compatible with county and local surveys. This corner position is acceptable as a careful and faithful perpetuation of the position of the original corner

C. Description of monument for corner and accessories established to perpetuate locating the position of the corner:

1997: Set monument box over found concrete monument with brass cap.

- Referenced:
- N72W-43.09'-Found tag in 18" oak (dead)
 - S15E-118.40'-Set tag in 20" triple oak
 - S26W-147.20'-Found spike in 12" double oak
 - N55W-112.73'-Found spike in 14" triple oak

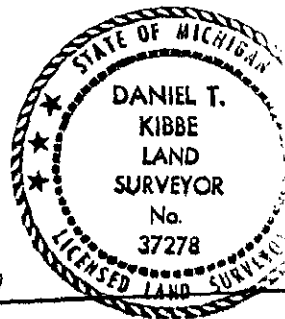

Signed by

Daniel T. Kibbe

Surveyor's Michigan License No. 37278

Date October 22, 1997