

1997 Alcona County Remonumentation Corner
LAND CORNER RECORDATION CERTIFICATE
 Filing Requirement of Act 74, Mich. P.A. 1970

APPROVED LAND CORNER
 P A 345 of 1980
 ALCONA COUNTY

For corners in

Alcona Located in: Corner Code #
 (County)

1. Public Land Survey T 27N R 8E C-13
 T ___ R ___
 T ___ R ___
 T ___ R ___

2. Property Controlling S ___ T ___ R ___
 in Section S ___ T ___ R ___

3. Miscellaneous S ___ T ___ R ___
 Property in Sec. S ___ T ___ R ___

Date 7/31/97
 County Rep. D. B. Con

RECORDED
 Date 10-31-1997
 REMON LIBER 1 PAGE 279
 Time 3:30 P M
Doris A. Gauthier
 Doris A. Gauthier
REGISTER OF DEEDS
 Register of Deeds Stamp & File Number

4. Lot No. _____, Recorded Plat _____
 5. Private Claims _____

I, Daniel T. Kibbe, in a field survey on April 1, 1997 do hereby state that under requirements of P.A. 74, Michigan P.A. of 1970, the corner points mentioned in lines 1 and 2 above were in conformance with regulations and rules therefore as required in the current manual of survey instructions of the United States Department of the Interior, Bureau of Land Management or by a decree of a Court of Law and/or that the corner points mentioned in lines 3, 4 and 5 above were in conformance with the rules of the Michigan Board of Land Surveyors or by a Decree of a Court of Law; established, re-established, monumented, recovered, found as expressed below:

A	B	C	D	E	F	G	H	I	J	K	L	M
1												
2	6	5	4	3	2	1						
3												
4	7	8	9	10	11	12						
5												
6	10	17	16	15	14	13						
7												
8	19	20	21	22	23	24						
9												
10	30	29	28	27	26	25						
11												
12	31	32	33	34	35	36						
13												

NOTE: Not more than 2 corners, all in the same town and range, may be recorded on this certificate.


- A. Description of original monument and accessories and/or subsequent restoration:
- 1843: GLO survey by Lewis Clason - Set post, referenced: Y. Pine 8"-N70E-16' / Y. Pine 24"-N20W-35'.
 - 1988: Certificate of Survey and L.C.R.C. by Robert F. Mitchell - Set con. mon w/brass cap, referenced: S24E - 8" R. Pine - 75.69' / S36W - 12" R. Pine - 71.24' / N47W - 12" R. Pine - 104.76' / N05W - 10" R. Pine - 88.22'.

B. Description of corner evidence found and/or method applied in restoring or reestablishing corner:

1997: Found concrete monument with brass cap 27' South of Q. This corner position is accepted as a careful and faithful perpetuation of the position of the original corner.

C. Description of monument for corner and accessories established to perpetuate locating the position of the corner:

1997: Found concrete monument with brass cap 27' South of Q.
 Referenced:
 N10W-87.63'-Found spike in 14" red pine
 N37W-104.97'-Found spike in 13" red pine
 S55W-71.26'-Found spike in 12" red pine
 S12E-75.70'-Found spike in 10" red pine
 East-19.84'-Found concrete monument with brass cap, C-1, T26N-R8E

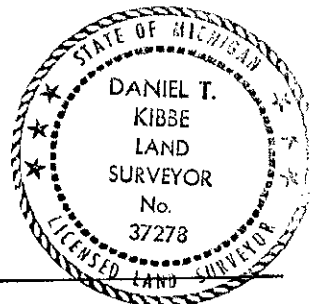

Signed by Daniel T. Kibbe
 Surveyor's Michigan License No. 37278

Date October 22, 1997