

FEB 07 2001

LAND CORNER RECORDATION CERTIFICATE

SECTION FILING REQUIREMENT OF ACT 74, MICH. P.A.1970

2000 Alcona County Remonumentation

FOR CORNERS OF--:	LOCATED IN--:	CORNER CODE NUMBER
1. PUBLIC LAND SURVEY	T. 27N N. S., R. 8E E. W.	E-11 ✓
2. PROPERTY CONTROLLING IN SECTION	T. N. S., R. E. W.	
3. MISCELLANEOUS PROPERTY IN SECTION	T. N. S., R. E. W.	
4. LOT NO. _____, RECORDED PLAT _____		
5. PRIVATE CLAIMS _____		

Alcona County Remonumentation Liber 2 Page 64

Filed for Record in ALCONA COUNTY MICHIGAN DORIS A GAUTHIER On 09-20-2000 At 09:36 am. LAND CORNER 9.00

REGISTER OF DEEDS STAMP AND FILING NUMBER

I, John F. Oliver do hereby certify that under requirements of P.A. 74, Michigan P.A. of 1970, the corner points mentioned in lines 1 and 2 above (identified with circles on index code diagram - over) were, in a field survey on Aug. 10, 2000 established, re-established, monumented, re-monumented, recovered or restored as expressed below and in conformance with regulations and rules therefore as required in the current manual of survey instructions of the United States Department of the Interior, Bureau of Land Management or by a decree of a court of law. Furthermore, that the corner points mentioned in lines 3, 4 and 5 above were, in a field survey on \_\_\_\_\_ 19\_\_\_\_, found, recovered, restored, established or re-established as expressed below and in conformance with the rules of the Michigan State Board of Registration for Land Surveyors or, by a Decree of a Court of law:

A. Description of original monument and accessories and/or subsequent restoration:

- E-11: 1838: GLO sur. by L. Clason
- 1906: sur. by E. Chapelle - cor. is called post
- 1913: sur. by A. Freer - cor. is railroad iron 31 inches long
- 1973: sur. by R. Miller - found 1" pipe
- 1976: sur. by Porter's Survey - found 1" pipe
- 1979: sur. by Scott Eng. - existing pipe
- 1993: sur. by J. Oliver - found 2" pipe
- 1993: sur. by Scott Eng - existing 1" pipe
- 1995: sur. by J. Oliver - found 1/2" pipe

B. Description of corner evidence found and/or method applied in restoring or re-establishing corner:

E-11: found 1" pipe with no cap

no evidence recovered from GLO survey of 1838

previous witnesses from 1976 Porter's Sur. and 1993 Scott Eng. survey verify location of the corner. distances and alignment are compatible with previous surveys of 1973, 1976, 1979, 1993 and 1995.

accepted as the correct location for the corner

C. Description of monument for corner and accessories established to perpetuate locating the position of the corner:

E-11: placed pavement box with 1/2" rod and brass cap referenced:

- 24" r. oak - N 68°E - 93.78 ft
- power pole - N 28°E - 109.64 ft
- 13" r. Oak - S 20°W - 78.51 ft
- power pole - S 10°E - 82.61 ft
- power pole - N 25°W - 107.41 ft


APPROVED LAND CORNER P A 345 of 1990 ALCONA COUNTY Date 7-6-2000 County Rep. J.F. Oliver

SIGNED BY John F. Oliver DATE Aug. 10, 2000 SURVEYOR'S MICHIGAN REGISTRATION NO. 19840

FOR STATE AND UNITED STATES AGENCIES:

SIGNED BY \_\_\_\_\_ DATE \_\_\_\_\_ CHIEF OF SURVEY PARTY

APPROVED AND SIGNED BY \_\_\_\_\_ DATE \_\_\_\_\_ MICHIGAN REGISTERED LAND SURVEYOR

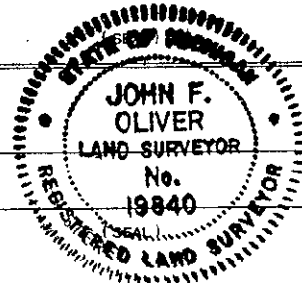

SURVEYOR'S MICHIGAN REGISTRATION NO. \_\_\_\_\_