

FEB 07 2001

2000 Alcona County Remonumentation

LAND CORNER RECORDATION CERTIFICATE
Filing Requirement of Act 74, Mich. P.A. 1970

SECTION

For corners in

Alcona
(County)

Located In: Corner Code # K-11 ✓

T27N, R8E.

- 1. Public Land Survey
 - T R
 - T R
 - T R
 - T R
- 2. Property Controlling in Section
 - S T R
 - S T R
- 3. Miscellaneous Property in Sec.
 - S T R
 - S T R

Alcona County
Remonumentation
Liber 2 Page 72

0
Filed for Record in
ALCONA COUNTY MICHIGAN
DORIS A GAUTHIER
On 09-20-2000 At 09:36 am.
LAND CORNER 9.00

Register of Deeds Stamp & File Number

- 4. Lot No. _____, Recorded Plat _____
- 5. Private Claims _____

I, John F. Oliver, in a field survey on Aug. 10, 2000 hereby state that under requirements of P.A. 74, Michigan P.A. of 1970, the corner points mentioned in lines 1 and 2 above were in conformance with regulations and rules therefore as required in the current manual of survey instructions of the United States Department of the Interior, Bureau of Land Management or by a decree of a Court of Law and /or that the corner points mentioned in lines 3, 4 and 5 above were in conformance with the rules of the Michigan Board of Land Surveyors or by a Decree of a Court of Law; established, re-established, monumented, recovered, found as expressed below:

NOTE: Not more than 2 corners, all in the same town and range, may be recorded on this certificate.

| | A | B | C | D | E | F | G | H | I | J | K | L | M |
|----|----|---|----|---|----|---|----|---|----|---|----|---|---|
| 1 | | | | | | | | | | | | | |
| 2 | 6 | | 5 | | 4 | | 3 | | 2 | | 1 | | |
| 3 | | | | | | | | | | | | | |
| 4 | 7 | | 8 | | 9 | | 10 | | 11 | | 12 | | |
| 5 | | | | | | | | | | | | | |
| 6 | 18 | | 17 | | 16 | | 15 | | 14 | | 13 | | |
| 7 | | | | | | | | | | | | | |
| 8 | 19 | | 20 | | 21 | | 22 | | 23 | | 24 | | |
| 9 | | | | | | | | | | | | | |
| 10 | 30 | | 29 | | 28 | | 27 | | 26 | | 25 | | |
| 11 | | | | | | | | | | | | | |
| 12 | 31 | | 32 | | 33 | | 34 | | 35 | | 36 | | |
| 13 | | | | | | | | | | | | | |

A. Description of original monument and accessories and/or subsequent restoration:

- K-11: 1838: GLO sur. by L. Clason - set post and referenced
- 1907: sur by E. Chapelle - corner is stake
- 1980: sur. by D. MacNeill - fd. 1" pipe
- 1986: sur. by NE sur. - corner not identified
- 2000: sur. by NE sur. - fd. 1" pipe


APPROVED LAND CORNER
P A 345 of 1990
ALCONA COUNTY
Date 8-28-2000
County Rep. J.F.O.

B. Description of corner evidence found and/or method applied in restoring or reestablishing corner:

- K-11: found 3/4" pipe and cap - number can not be read
- no evidence recovered from GLO survey of 1838
- previous witnesses from sur. of 2000 found distances and alignment are compatible with surveys of 1980, 1986 and 2000.
- accepted as the correct location for the corner

C. Description of monument for corner and accessories established to perpetuate locating the position of the corner:

- K-11: placed pavement box with 1/2" rod and brass cap referenced:
 - 8" aspen - N 45°W - 42.01 ft
 - 10" aspen - S 85°E - 32.91 ft
 - 8" w. pine - S 52°E - 33.39 ft
 - 4" spruce - S 56°W - 37.65 ft

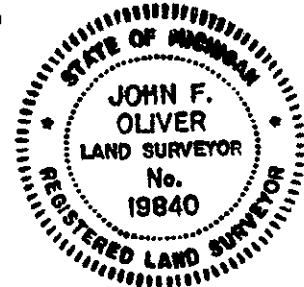

Signed by _____
Surveyor's Michigan License No. 19840

Date Aug. 10, 2000