

**SURVEY & REMONUMENTATION**

DEC 16 1996

COMMISSION

1996 ALCONA COUNTY REMONUMENTATION CORNER

**LAND CORNER RECORDATION CERTIFICATE**

Filing Requirement of Act 74, Mich. P.A. 1970

For corners in \_\_\_\_\_

Alcona  
(County)

Located In: \_\_\_\_\_

Corner Code # \_\_\_\_\_

Alcona County

Re-monumentation 198  
Liber \_\_\_\_\_ Page \_\_\_\_\_

- 1. Public Land Survey T 27N R 8E  
T \_\_\_\_\_ R \_\_\_\_\_  
T \_\_\_\_\_ R \_\_\_\_\_  
T 27N R 9E
- 2. Property Controlling in Section S \_\_\_\_\_ T \_\_\_\_\_ R \_\_\_\_\_  
S \_\_\_\_\_ T \_\_\_\_\_ R \_\_\_\_\_
- 3. Miscellaneous S \_\_\_\_\_ T \_\_\_\_\_ R \_\_\_\_\_  
Property in Section S \_\_\_\_\_ T \_\_\_\_\_ R \_\_\_\_\_

APPROVED LAND CORNER  
 H A 345 of 1990  
 ALCONA COUNTY  
 Date 11-15-96  
 County Rep. E.L.L.

Nov 18 8 44 AM '96  
*David A. Gaudin*  
 REGISTER CLERK  
 ALCONA COUNTY

Register of Deeds Stamp & File Number

- 4. Lot No. \_\_\_\_\_, Recorded Plat \_\_\_\_\_
- 5. Private Claims \_\_\_\_\_

**T27N-R8E**

	A	B	C	D	E	F	G	H	I	J	K	L	M
2	6		5		4		3		2				
3													
4	7		8		9		10		11		12		
5													
6	18		17		16		15		14		13		
7													
8	19		20		21		22		23		24		
9													
10	30		29		28		27		26		25		
11													
12	31		32		33		34		35		36		
13													

I, Thomas L. Fabis, in a field survey on November 7, 1996, do hereby certify that under requirements of P.A. 74, Michigan P.A. of 1970, the corner points mentioned in lines 1 and 2 above were in conformance with regulations and rules therefore as required in the current manual of survey instructions of the United States Department of the Interior, Bureau of Land Management or by a decree of a Court of Law and/or that the corner points mentioned in lines 3, 4 and 5 above were in conformance with the rules of the Michigan Board of Professional Surveyors or by a Decree of a Court of Law; established, re-established, monumented, re-monumented, recovered, found as expressed below:

**NOTE: Not more than 4 corners, all in the same town and range, may be recorded on this certificate.**

**A. Description of original monument and accessories and/or subsequent restoration:**

- 1838: G.L.O. Survey by Lewis Clason - Set post & referenced: (S. Maple 10 - S16W - 38, Beech 10 - N52W - 44).
- 1985: Survey (Liber 201 Page 17) by John Oliver - Set R.R. Spike
- 1989: U.S.D.A. Survey (Liber 227 Pages 798 & 799) by Robert Mitchell - Set conc. monument w/ Brass cap & referenced.
- 1990: Survey (Liber 249 Page 128) by Duane MacNeill - Found P.K. Nail
- 1994: MDOT Survey by Clifford Lindgren - Found Conc. Mon. with Brass Disk & referenced.


**B. Description of corner evidence found and/or method applied in restoring or reestablishing corner:**

- 1996: Found Conc. Monument w/Brass Cap in centerline of paved road and 3 existing witnesses.

The position of this corner is compatible with State, Federal and local surveys and is accepted as a careful and faithful perpetuation of the position of the original corner.

**C. Description of monument for corner and accessories established to perpetuate locating the position of the corner:**

- 1996: Set Monument Box around existing conc. monument with Brass Cap.
- References:
- 10" Cedar - S60W - 47.75'
  - 8" Jack Pine - N48E - 119.16'
  - 24" Twin W. Birch - N80E - 104.05'
  - 1/2" iron rod N.E.L.S. - DUE EAST - 33.10'

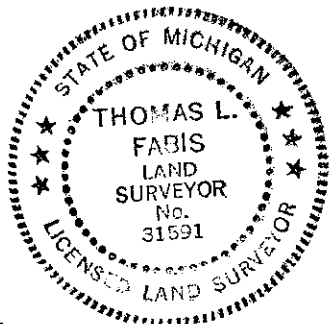

Signed by Thomas L. Fabis

Date November 14, 1996

Surveyor's Michigan License No. 31591