

SURVEY &
REMONUMENTATION

DEC 16 1985

CONTRACT

1996 ALCONA COUNTY REMONUMENTATION CORNER

LAND CORNER RECORDATION CERTIFICATE

Filing Requirement of Act 74, Mich. P.A. 1970

Alcona
Remon
Liber 195

RECORDED

For corners in

Alcona
(County)

Located In:

Corner Code #

1. Public Land Survey

T 27N R 8E

M-3

T R

Hawes Twp.

T R

T 27N R 9E

A-3

S T R

Haynes Twp.

S T R

2. Property Controlling
in Section

3. Miscellaneous

Property in Section

4. Lot No. _____, Recorded Plat _____

5. Private Claims _____

APPROVED LAND SURVEYOR
P.A. 34E
ALCONA

Date 11-15-96
County E.T.L.

Nov 18 8 44 AM '96

James A. Guthrie
REGISTERED SURVEYOR
MICHIGAN

Register of Deeds Stamp & File Number

I, Thomas L. Fabis, in a field survey on November 7, 1996, do hereby certify that under requirements of P.A. 74, Michigan P.A. of 1970, the corner points mentioned in lines 1 and 2 above were in conformance with regulations and rules therefore as required in the current manual of survey instructions of the United States Department of the Interior, Bureau of Land Management or by a decree of a Court of Law and/or that the corner points mentioned in lines 3, 4 and 5 above were in conformance with the rules of the Michigan Board of Professional Surveyors or by a Decree of a Court of Law; established, re-established, monumented, re-monumented, recovered, found as expressed below:

NOTE: Not more than 4 corners, all in the same town and range, may be recorded on this certificate.

T27N - R8E

A	B	C	D	E	F	G	H	I	J	K	L
2	6	5	4	3	2	1					
3											
4	7	8	9	10	11	12					
5											
6	18	17	16	15	14	13					
7											
8	19	20	21	22	23	24					
9											
10	30	29	28	27	26	25					
11											
12	31	32	33	34	35	36					
13											

A. Description of original monument and accessories and/or subsequent restoration:

- 1838: G.L.O. Survey by Lewis Clason - Set post & referenced: (Beech 11 - S57W - 24, W. Pine 26 - N64W - 52).
- 1979: Survey (Liber 178 Page 484) by Duane MacNeill - Found P.K. over strong pull & referenced
- 1985: Survey by John Oliver (Liber 201 Page 17) - Found P.K. over iron
- 1989: Survey (Liber 227 Pages 798 & 799) by Robert Mitchell - Found iron bar in centerline of roads N, S & W and referenced.
- 1990: Survey (Liber 249 Page 128) by Duane MacNeill - Found P.K. nail.
- 1993: Survey (Liber 260 Page 450) by Duane MacNeill - Found P.K. nail over pipe.
- 1994: MDOT Survey by Clifford Lindgren - Found Conc. Mon. with Brass Cap & referenced.


B. Description of corner evidence found and/or method applied in restoring or reestablishing corner:

- 1996: Found 60 penny nail over conc. monument with brass cap at intersection of roads and 4 existing witnesses.

The position of this corner is compatible with State, Federal and local surveys and is accepted as a careful and faithful perpetuation of the position of the original corner.

C. Description of monument for corner and accessories established to perpetuate locating the position of the corner:

- 1996: Set Monument Box around existing conc. monument with brass cap.
Existing witnesses are as follows:
S58W - 75.98' - 15" Blazed R. Pine
S70E - 101.63' - 7" Blazed Maple
N72E - 115.70' - 7" Blazed Oak
N65W - 130.72' - P. Pole

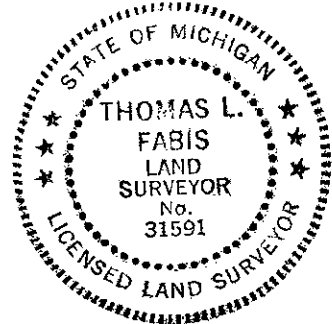

Signed by Thomas L. Fabis

Date November 14, 1996

Surveyor's Michigan License No. 31591