

DEC 16 1996

COMMUNICATED

1996 ALCONA COUNTY REMONUMENTATION CORNER Alcona County

LAND CORNER RECORDATION CERTIFICATE

Remonumentation  
Liber 1 Page 194

Filing Requirement of Act 74, Mich. P.A. 1970

For corners in

Alcona  
(County)

Located in:

Corner Code #

RECORDED

- 1. Public Land Survey T 27N R 8E
- T R
- T R
- T 27N R 9E
- 2. Property Controlling S T R
- in Section S T R
- 3. Miscellaneous S T R
- Property in Section S T R

M-4

Hawes Twp.

A-4

Haynes Twp.

APPROVED LAND CORNER  
P.A. 345 of 1990  
ALCONA COUNTY

Date: 11-15-96

County Rep. E.T.L.

Nov 18 8 41 AM '96

*David A. ...*  
REGISTER OF DEEDS  
ALCONA COUNTY, MICHIGAN

Register of Deeds Stamp & File Number

- 4. Lot No. \_\_\_\_\_, Recorded Plat \_\_\_\_\_
- 5. Private Claims \_\_\_\_\_

T27N - R8E

	A	B	C	D	E	F	G	H	I	J	K	L	M
2	6		5		4		3		2		1		
3													
4	7		8		9		10		11		12		
5													
6	18		17		16		15		14		13		
7													
8	19		20		21		22		23		24		
9													
10	30		29		28		27		26		25		
11													
12	31		32		33		34		35		36		
13													

I, Thomas L. Fabis, in a field survey on November 7, 1996, do hereby certify that under requirements of P.A. 74, Michigan P.A. of 1970, the corner points mentioned in lines 1 and 2 above were in conformance with regulations and rules therefore as required in the current manual of survey instructions of the United States Department of the Interior, Bureau of Land Management or by a decree of a Court of Law and/or that the corner points mentioned in lines 3, 4 and 5 above were in conformance with the rules of the Michigan Board of Professional Surveyors or by a Decree of a Court of Law; established, re-established, monumented, re-monumented, recovered, found as expressed below:

NOTE: Not more than 4 corners, all in the same town and range, may be recorded on this certificate.

A. Description of original monument and accessories and/or subsequent restoration:

- 1838: G.L.O. Survey by Lewis Clason - Set post & referenced: (Y. Pine 16 - S26W - 34, W. Pine 18 - N59W - 33).
- 1993: Survey (Liber 260 Page 450) by Duane MacNeill - Found P.K. over pipe.
- 1994: MDOT Survey by Clifford Lindgren - Found 1/2" Rod and referenced.

B. Description of corner evidence found and/or method applied in restoring or reestablishing corner:

- 1996: Found 1/2" iron rod at the intersection of paved roads N & S and East and 4 existing witnesses which match the MDOT Survey.


The position of this corner is compatible with State and local surveys and is accepted as a careful and faithful perpetuation of the position of the original corner.

C. Description of monument for corner and accessories established to perpetuate locating the position of the corner:

- 1996: Set 3" dia. brass cap, stamped to identify the corner over the existing 1/2" iron rod and set a Monument Box around it.

References:

- 5" Maple - N45W - 47.71'
- 14" Scotch Pine - N80W - 34.58'
- P. Pole - S34W - 113.28'
- Prop. Corner - N50E - 46.90'

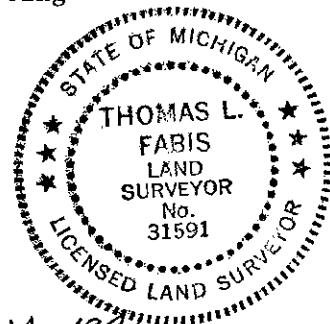

Signed by Thomas L. Fabis

Date November 14, 1996

Surveyor's Michigan License No. 31591