

SURVEY & REMONUMENTATION

DEC 16 1996

COMMISSION

1996 ALCONA COUNTY REMONUMENTATION CORNER
LAND CORNER RECORDATION CERTIFICATE
 Filing Requirement of Act 74, Mich. P.A. 1970

Alcona County
 Remonumentation
 Liber 1 Page 208

For corners in Alcona
 (County)

Located In:

Corner Code #

RECORDED

- 1. Public Land Survey T 27N R 8E
- T _____ R _____
- T _____ R _____
- T 27N R 9E
- 2. Property Controlling S _____ T _____ R _____
 in Section S _____ T _____ R _____
- 3. Miscellaneous S _____ T _____ R _____
 Property in Section S _____ T _____ R _____

M-6
Hawes Twp.

A-6
Haynes Twp.

APPROVED LAND CORNER

P. A. 345 of 1990

ALCONA COUNTY

Date 11-15-96

County Rep E.T.L.

Nov 18 8 48 AM '96

James A. Benthies
 REGISTER OF DEEDS
 ALCONA COUNTY

Register of Deeds Stamp & File Number

- 4. Lot No. _____, Recorded Plat _____
- 5. Private Claims _____

T27N-R8E

	A	B	C	D	E	F	G	H	I	J	K	L
2	6		5		4		3		2		1	
3												
4	7		8		9		10		11		12	
5												
6	18		17		16		15		14		13	
7												
8	19		20		21		22		23		24	
9												
10	30		29		28		27		26		25	
11												
12	31		32		33		34		35		36	
13												

I, Thomas L. Fabis, in a field survey on November 8, 1996, do hereby certify that under requirements of P.A. 74, Michigan P.A. of 1970, the corner points mentioned in lines 1 and 2 above were in conformance with regulations and rules therefore as required in the current manual of survey instructions of the United States Department of the Interior, Bureau of Land Management or by a decree of a Court of Law and/or that the corner points mentioned in lines 3, 4 and 5 above were in conformance with the rules of the Michigan Board of Professional Surveyors or by a Decree of a Court of Law; established, re-established, monumented, re-monumented, recovered, found as expressed below:

NOTE: Not more than 4 corners, all in the same town and range, may be recorded on this certificate.

A. Description of original monument and accessories and/or subsequent restoration:

- 1838: G.L.O. Survey by Lewis Clason - Set post & referenced: (W. Pine 20 - S66W - 17, Y. Pine 20 - N50W - 29).
- 1978: Surveys (Liber 170 Pages 793 & 794) by Duane MacNeill - Found 1/2" x 4" steel & referenced.
- 1978: Unrecorded Survey (R.S.Scott W.O. 1-1207) by David Guthrie - Set 1/2" iron & referenced.
- 1986: Survey (Liber 218 Page 721) by Duane MacNeill - Ties to corner from the West.
- 1987: Unrecorded survey (W.O. 1-39) by Earl Lewis - Found existing Nail & referenced.
- 1994: MDOT Survey by Clifford Lindgren - Found 1" Iron Pin and referenced.

B. Description of corner evidence found and/or method applied in restoring or reestablishing corner:

- 1996: Found 1/2" x 4" Steel 6.8' West of centerline of paved road and 2 of the 3 witnesses as described in the recorded surveys by Duane MacNeill.

This corner is accepted as a careful and faithful perpetuation of the position of the original corner.

Note: Also found 1/2" iron rod in center of road which is being used by MDOT as a road alignment P.I.


C. Description of monument for corner and accessories established to perpetuate locating the position of the corner:

- 1996: Set 1/2" iron rod next to existing 1/2" x 4" Steel and capped it with a 3" dia. brass cap, stamped to identify the corner. A Monument Box was set around the corner.

References:

- 6" Aspen - N60E - 46.81'
- 8" Aspen - N40E - 65.68'
- Fe. Post - West - 42.48'
- 4" J. Pine - S55W - 57.23'
- 6" W. Pine - S30E - 81.31'
- 1/2" iron rod P.I. - S80E - 6.80'
- 3/4" pipe #19237 - East - 33.00'

Signed by Thomas L. Fabis
 Surveyor's Michigan License No. 31591

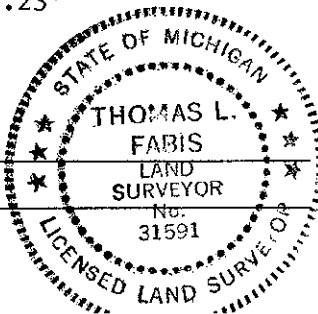

Date November 14, 1996