

1993 Alcona County Remonumentation Corner

LAND CORNER RECORDATION CERTIFICATE
Filing Requirement of Act 74, Mich. P.A. 1970

For corners in

<u>Alcona</u>	Located In:	Corner Code #
(County)		
1. Public Land Survey	T <u>27N</u> R <u>8E</u>	<u>M-7</u>
	T _____ R _____	_____
	T _____ R _____	_____
	T _____ R _____	_____
2. Property Controlling in Section	S _____ T _____ R _____	_____
	S _____ T _____ R _____	_____
3. Miscellaneous Property in Sec.	S _____ T _____ R _____	_____
	S _____ T _____ R _____	_____

RECORDED
 Remon 1 Page 18
 Dec 20 1 19 PM '93

David A. Guthrie
 REGISTER OF DEEDS
 ALCONA COUNTY MICHIGAN

Register of Deeds Stamp & File Number

4. Lot No. _____, Recorded Plat _____
 5. Private Claims _____

A	B	C	D	E	F	G	H	I	J	K	L	M
2	6	5	4	3	2	1						
3												
4	7	8	9	10	11	12						
5												
6	18	17	16	15	14	13						
7												
8	19	20	21	22	23	24						
9												
10	30	29	28	27	26	25						
11												
12	31	32	33	34	35	36						
13												

I, David B. Guthrie in a field survey on August 20, 19 93, do hereby certify that under requirements of P.A. 74, Michigan P.A. of 1970, the corner points mentioned in lines 1 and 2 above were in conformance with regulations and rules therefore as required in the current manual of survey instructions of the United States Department of the Interior, Bureau of Land Management or by a decree of a Court of Law and/or that the corner points mentioned in lines 3, 4 and 5 above were in conformance with the rules of the Michigan Board of Land Surveyors or by a Decree of a Court of Law, established, re-established, monumented, re-monumented, recovered, found as expressed below:

NOTE: Not more than 4 corners, all in the same town and range, may be recorded on this certificate.

A. Description of original monument and accessories and/or subsequent restoration:


- 1838 - G.L.O. Survey by Lewis Clason - Set post and referenced Y. Pine 24 - S30°W - 29 / Beach 10 - N57°W - 24
- 1978 - Survey by David B. Guthrie - Found nail in road intersection.

B. Description of corner evidence found and/or method applied in restoring or reestablishing corner:

- 1993 - Found 1/2" Iron Rod with cap by D.R. MacNeill in the road intersection - This corner is accepted and used for local surveys.

C. Description of monument for corner and accessories established to perpetuate locating the position of the corner:

- 1993: Set 1/2" X 24" Iron Rod with 3" brass cap stamped to identify the corner Referenced:
 N37°W - Fence Corner Post - 53.43 Feet
 S83°W - Utility Pole - 98.56 Feet
 N56°W - Utility Pole - 107.00 Feet
 N18°W - 24" Maple - 148.69 Feet

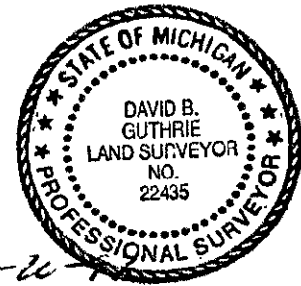

Signed by *David B. Guthrie* Date 12-20-93
 Surveyor's Michigan License No. 22435