

**SURVEY &  
REMONUMENTATION**

DEC 16 1996

COMMISSION

1996 ALCONA COUNTY REMONUMENTATION CORNER  
**LAND CORNER RECORDATION CERTIFICATE**  
Filing Requirement of Act 74, Mich. P.A. 1970

Alcona County  
Remonumentation  
Liber 1 Page 196

For corners in Alcona (County) Located In: Corner Code #

1. Public Land Survey	T	<u>27N</u>	R	<u>8E</u>	M-5			
	T		R		Haynes Twp.			
	T		R					
2. Property Controlling in Section	S		T	<u>27N</u>	R	<u>9E</u>	A-5	Haynes Twp.
	S		T		R			
3. Miscellaneous Property in Section	S		T		R			
	S		T		R			

APPROVED LAND CORNER  
P A 345 of 1990  
ALCONA COUNTY

RECORDED

Nov 18 8 44 AM '96

*Janis A. Newthick*  
REGISTERED SURVEYOR  
MICHIGAN

County Register of Deeds Stamp & File Number

4. Lot No. \_\_\_\_\_, Recorded Plat \_\_\_\_\_  
5. Private Claims \_\_\_\_\_

T27N-R8E

	A	B	C	D	E	F	G	H	I	J	K	L
2	6		5		4		3		2		1	
3												
4	7		8		9		10		11		12	
5												
6	18		17		16		15		14		13	
7												
8	19		20		21		22		23		24	
9												
10	30		29		28		27		26		25	
11												
12	31		32		33		34		35		36	
13												

I, Thomas L. Fabis, in a field survey on November 7, 1996, do hereby certify that under requirements of P.A. 74, Michigan P.A. of 1970, the corner points mentioned in lines 1 and 2 above were in conformance with regulations and rules therefore as required in the current manual of survey instructions of the United States Department of the Interior, Bureau of Land Management or by a decree of a Court of Law and/or that the corner points mentioned in lines 3, 4 and 5 above were in conformance with the rules of the Michigan Board of Professional Surveyors or by a Decree of a Court of Law; established, re-established, monumented, re-monumented, recovered, found as expressed below:

**NOTE: Not more than 4 corners, all in the same town and range, may be recorded on this certificate.**

**A. Description of original monument and accessories and/or subsequent restoration:**

- 1838: G.L.O. Survey by Lewis Clason - Set post & referenced: (Y. Pine 26 - S64W - 27, Beech 11 - N42W - 30).
- 1902: County Survey by Ed Chapelle - For cor. post a Gray Boulder 8 x 18 + on top, Glass & Crockery under it.
- 1953: Road Survey by R.S.Scott Eng. Co. - 8" Spike & referenced.
- 1978: Surveys (Liber 170 Pages 793 & 794) by Duane MacNeill - Found large spike & referenced.
- 1978: Survey (R.S.Scott W.O. 1-1207) by David Guthrie - Found 1/2" Iron Rod & referenced.
- 1987: Survey (W.O. 1-39) by Earl Lewis - Found Existing Nail & referenced.
- 1994: MDOT Survey by Clifford Lindgren - Found pipe & cap #19237 and referenced.

**B. Description of corner evidence found and/or method applied in restoring or reestablishing corner:**

- 1996: Found capped 1/2" iron rod in the centerline of paved road and 3 existing witnesses which harmonizes with the previous local surveys mentioned above.


This corner is accepted as a careful and faithful perpetuation of the position of the original corner.

**C. Description of monument for corner and accessories established to perpetuate locating the position of the corner:**

- 1996: Set 3" dia. brass cap, stamped to identify the corner over the existing 1/2" iron rod and set a Monument Box around it.

References:

- Power Pole - N25W - 78.70'
- Fe. Cor. Post - N45W - 44.10'
- 8" Spruce - S65W - 60.70'
- 6" J. Pine - S60E - 119.22'

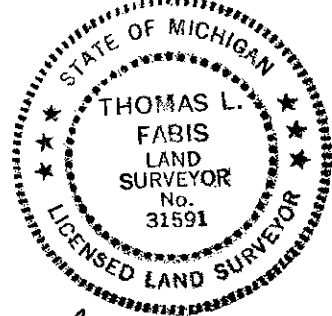

Signed by Thomas L. Fabis

Date November 14, 1996

Surveyor's Michigan License No. 31591