

SURVEY & REMONUMENTATION

DEC 16 1996

1996 ALCONA COUNTY REMONUMENTATION CORNER

Alcona County Remonumentation Liber 1 Page 203

COMMISSION

LAND CORNER RECORDATION CERTIFICATE

Filing Requirement of Act 74, Mich. P.A. 1970

For corners in

Alcona
(County)


Located In:

Corner Code #

- | | | | | | |
|--------------------------------------|---|------------|---|-----------|--------------------|
| 1. Public Land Survey | T | <u>27N</u> | R | <u>9E</u> | <u>C-5</u> |
| | T | | R | | <u>Haynes Twp.</u> |
| | T | | R | | |
| | T | | R | | |
| 2. Property Controlling in Section | S | | T | | |
| | S | | T | | |
| 3. Miscellaneous Property in Section | S | | T | | |
| | S | | T | | |

RECORDED
Nov 18 8 45 AM '96
APPROVED LAND CORNER
P.A. 345 of 1990
ALCONA COUNTY
11-15-96
REGISTERED
County Reg
Register of Deeds Stamp & File Number

4. Lot No. _____, Recorded Plat _____
5. Private Claims _____

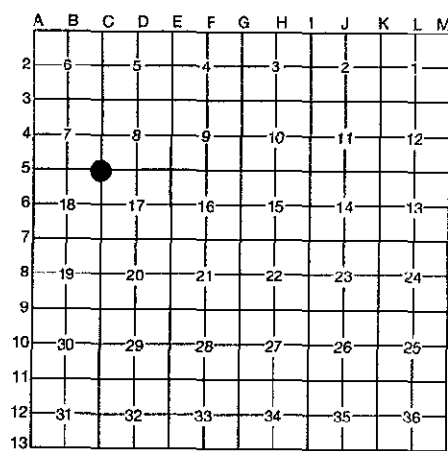

I, Thomas L. Fabis, in a field survey on November 8, 1996, do hereby certify that under requirements of P.A. 74, Michigan P.A. of 1970, the corner points mentioned in lines 1 and 2 above were in conformance with regulations and rules therefore as required in the current manual of survey instructions of the United States Department of the Interior, Bureau of Land Management or by a decree of a Court of Law and/or that the corner points mentioned in lines 3, 4 and 5 above were in conformance with the rules of the Michigan Board of Professional Surveyors or by a Decree of a Court of Law; established, re-established, monumented, re-monumented, recovered, found as expressed below:

NOTE: Not more than 4 corners, all in the same town and range, may be recorded on this certificate.

A. Description of original monument and accessories and/or subsequent restoration:

- 1840: G.L.O. Survey by Thos. Pattison - Set post. No trees given.
- Early County Survey: Visited corner and referenced. (Surveyor Unknown)
- 1953: Road Alignment Survey by R.S. Scott Engineering Co. - 1/2" Rod and referenced.
- 1988: L.C.R.C. by Robert Mitchell - Found 1 1/2" x 1/2" iron rod 24" below road surface. Raised with 1/2" iron rod capped #28417 and referenced.

B. Description of corner evidence found and/or method applied in restoring or reestablishing corner:

- 1996: Found 1/2" iron rod capped R.F.M. P.S.#28417 and 4 existing witnesses as per L.C.R.C. by Robert Mitchell.


This corner is accepted as a careful and faithful perpetuation of the position of the original corner.

C. Description of monument for corner and accessories established to perpetuate locating the position of the corner:

- 1996: Removed existing plastic cap P.S.#28417 and set 3" dia. Brass cap, stamped to identify corner over existing 1/2" iron rod and set Monument Box around corner.

References:

- Tele. Pole - S45W - 104.02'
- 4" Cherry - S45E - 87.09'
- 8" Tamerack - N30E - 53.98'
- 8" Twin Tam. - N35W - 60.55'

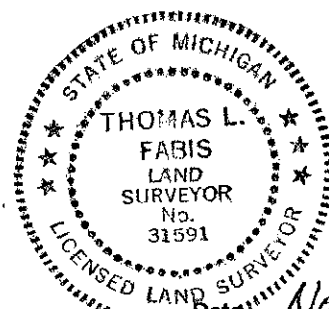

Signed by Thomas L. Fabis

Date November 13, 1996

Surveyor's Michigan License No. 31591