

**SURVEY & REMONUMENTATION**

DEC 16 1996

COMMISSION

1996 ALCONA COUNTY REMONUMENTATION CORNER  
**LAND CORNER RECORDATION CERTIFICATE**  
 Filing Requirement of Act 74, Mich. P.A. 1970

Alcona County Remonumentation  
 Liber 1 Page 207

For corners in	<u>Alcona</u> (County)	Located In:	Corner Code #
1. Public Land Survey	T <u>27N</u> R <u>9E</u>		D-5
	T _____ R _____		Haynes Twp.
	T _____ R _____		
	T _____ R _____		
2. Property Controlling in Section	S _____ T _____ R _____		
	S _____ T _____ R _____		
3. Miscellaneous Property in Section	S _____ T _____ R _____		
	S _____ T _____ R _____		

APPROVED LAND CORNER  
 P.A. 345 of 1990  
 ALCONA COUNTY  
 2-7-96  
 11/5/96


RECORDED

NOV 18 8 48 AM '96

*David A. Benthien*  
 REGISTERED PROFESSIONAL SURVEYOR

Register of Deeds Stamp & File Number

4. Lot No. \_\_\_\_\_, Recorded Plat \_\_\_\_\_  
 5. Private Claims \_\_\_\_\_

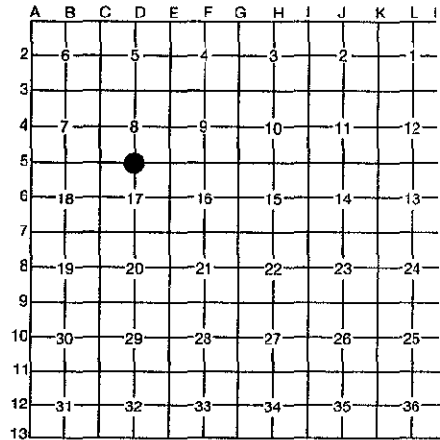

I, Thomas L. Fabis, in a field survey on November 8, 1996, do hereby certify that under requirements of P.A. 74, Michigan P.A. of 1970, the corner points mentioned in lines 1 and 2 above were in conformance with regulations and rules therefore as required in the current manual of survey instructions of the United States Department of the Interior, Bureau of Land Management or by a decree of a Court of Law and/or that the corner points mentioned in lines 3, 4 and 5 above were in conformance with the rules of the Michigan Board of Professional Surveyors or by a Decree of a Court of Law; established, re-established, monumented, re-monumented, recovered, found as expressed below:


**NOTE: Not more than 4 corners, all in the same town and range, may be recorded on this certificate.**

- A. Description of original monument and accessories and/or subsequent restoration:**
- 1840: G.L.O. Survey by Thos. Pattison - Set post & referenced: (Hem 18 - N60W - 10, Hem 16 - S35E - 20)
  - Early County Survey: (Surveyor Unknown) - Gray Flinty Boulder 9 x 12 x 18 + on top, glass under it.
  - 1953: Road Alignment Survey by R.S. Scott Engineering Co. - 1/2" Rod and referenced: (North - 32.8' - fence post, South - 44.1' - fence post).

- B. Description of corner evidence found and/or method applied in restoring or reestablishing corner:**
- 1996: Did not find any existing physical corner material or monumentation. Set 1/2" iron rod at intersection of centerline of paved road and 1/4 line fences South & North.

The position of this corner is compatible with the 1953 Road Survey and is accepted as the best available evidence of the position of the original corner.

- C. Description of monument for corner and accessories established to perpetuate locating the position of the corner:**
- 1996: Set 3" dia. Brass cap, stamped to identify the corner over a 1/2" iron rod and set a Monument Box around the corner. Set tags #31591 in the following reestablished witnesses:  
 P. Pole - N5E - 66.16'  
 3" Balm of Gilead - S45E - 48.49'  
 7" Apple - S5E - 45.13'  
 Fe. Post - S60W - 45.52'

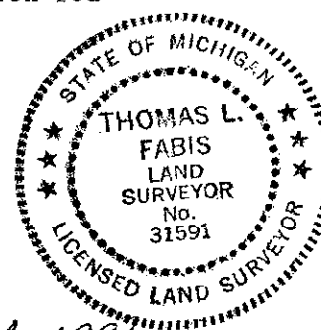

Signed by Thomas L. Fabis Date November 14, 1996