

SURVEY & REMONUMENTATION

FEB 19 1999

SECTION

1998 Alcona County Remonumentation Corner LAND CORNER RECORDATION CERTIFICATE Filing Requirement of Act 74, Mich. P.A. 1970

For corners in

Alcona	Located In:	Corner Code #
(County)		
1. Public Land Survey	T <u>27N</u> R <u>9E</u>	<u>D-9</u>
	T _____ R _____	_____
	T _____ R _____	_____
	T _____ R _____	_____
2. Property Controlling in Section	S _____ T _____ R _____	_____
	S _____ T _____ R _____	_____
3. Miscellaneous Property in Sec.	S _____ T _____ R _____	_____
	S _____ T _____ R _____	_____
4. Lot No. _____, Recorded Plat _____		
5. Private Claims _____		

0
Filed for Record in
ALCONA COUNTY MICHIGAN
DORIS A GAUTHIER
On 12-11-1998 At 03:30:15 pm.
LAND CORNER 9.00

APPROVED LAND CORNER
P A 345 of 1990
ALCONA COUNTY
Date: 9/26/98
County Rep: D.T. Kibbe

Alcona County Remonumentation Liber Page 308

Register of Deeds Stamp & File Number

	A	B	C	D	E	F	G	H	I	J	K	L
1												
2	6		5		4		3		2		1	
3												
4	7		8		9		10		11		12	
5												
6	18		17		16		15		14		13	
7												
8	19		20		21		22		23		24	
9												
10	30		29		28		27		26		25	
11												
12	31		32		33		34		35		36	
13												

I, Daniel T. Kibbe, in a field survey on April 8, 1998 do hereby state that under requirements of P.A. 74, Michigan P.A. of 1970, the corner points mentioned in lines 1 and 2 above were in conformance with regulations and rules therefore as required in the current manual of survey instructions of the United States Department of the Interior, Bureau of Land Management or by a decree of a Court of Law and for that the corner points mentioned in lines 3, 4 and 5 above were in conformance with the rules of the Michigan Board of Land Surveyors or by a Decree of a Court of Law; established, re-established, monumented, recovered, found as expressed below:

NOTE: Not more than 2 corners, all in the same town and range, may be recorded on this certificate.

A. Description of original monument and accessories and/or subsequent restoration:

- 1840: GLO Survey by Thos. Pattison - Set 1/4 section post, referenced: Beech 10-S50W-40/Beech 10-N52E-57
- 1908: County Survey by A.J. Freer - Cedar post, referenced: W. Pine stump 38-N8E-99/W. Pine stump 40-S47W-79
- 1996: Field notes by Hank Grush - No corner found or identified.


B. Description of corner evidence found and/or method applied in restoring or reestablishing corner:

1998: Remon Survey by Daniel T. Kibbe - Found no corner or corner evidence. Found 33' R.O.W. irons both North and South of the 1/8 corner position between C-9 and D-9. Found no 1/8 corner. Split the found R.O.W. irons to establish 1/8 corner position and doubled this position over from corner C-9 to establish D-9. Set PK 10' east of fence line to north, 7' south of C.L. of E-W Road.

This corner position is compatible with county & local surveys. This corner position is accepted as a careful and faithful perpetuation of the position of the original corner.

C. Description of monument for corner and accessories established to perpetuate locating the position of the corner:

- 1998: Placed 3" Alcona County cap stamped to identify the corner over 1/2" iron rod in monument box.
- Referenced:
 - Set tag in power pole-N20°E-38.32'
 - Set tag in power pole-S68°E-90.21'
 - Set tag in 24" Maple-S35°W-40.71'
 - Top center of GTE Riser Box-N05°W-39.38'

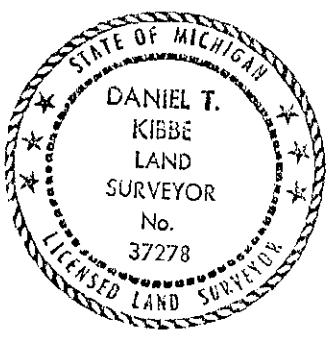

Signed by Daniel T. Kibbe
Surveyor's Michigan License No. 37278

Date December 7, 1998