

OCT 26 1995

COMMISSION

Alcona County Remonumentation Liber 1 Page 135

1995 ALCONA COUNTY REMONUMENTATION CORNER

RECORDED

OCT 2 2 36 PM '95

LAND CORNER RECORDATION CERTIFICATE Filing Requirement of Act 74, Mich. P.A. 1970

For corners in

Alcona

(County)

Located In:

Corner Code #

1. Public Land Survey

T 27N R 9E

E-4 (W 1/4, 9)

(Haynes Twp.)

T R

T R

T R

T R

2. Property Controlling in Section

S T R

S T R

3. Miscellaneous Property in Sec.

S T R

S T R

4. Lot No. , Recorded Plat

5. Private Claims

Doris A. Benthley REGISTER OF DEEDS ALCONA COUNTY MICHIGAN

APPROVED LAND CORNER P A 345 of 1990 ALCONA COUNTY

Date 10-2-95

County Rep E. J. L. Register of Deeds Stamp & File Number

I, Thomas L. Fabis, in a field survey on September 15, 1995, do hereby certify that under requirements of P.A. 74, Michigan P.A. of 1970, the corner points mentioned in lines 1 and 2 above were in conformance with regulations and rules therefore as required in the current manual of survey instructions of the United States Department of the Interior, Bureau of Land Management or by a decree of a Court of Law and/or that the corner points mentioned in lines 3, 4 and 5 above were in conformance with the rules of the Michigan Board of Land Surveyors or by a Decree of a Court of Law; established, re-established, monumented, re-monumented, recovered, found as expressed below:

NOTE: Not more than 4 corners, all in the same town and range, may be recorded on this certificate.

Grid table with columns A-M and rows 2-13. A dot is marked at the intersection of column E and row 4.

A. Description of original monument and accessories and/or subsequent restoration:

1840: G.L.O. Survey by Thos. Pattison - Set post & referenced: (Cedar 10 - N34E - 16, Hem. 14 - S18W - 22)

1889+: County Survey - Describes it as Dark Boulder 9x12x14 with "x" on top, glass under it.

1981: Unrecorded survey by John F. Oliver - Found 3/4" pipe.

1988: L.C.R.C. Liber 1 Page 363 by Robert F. Mitchell - Found 3/4" iron pipe and referenced it during a survey for the U.S.D.A.

B. Description of corner evidence found and/or method applied in restoring or reestablishing corner:

1995: Found 3/4" iron pipe and the following existing witnesses as per the 1988 L.C.R.C. by Robert F. Mitchell: (6" R. Pine - N23E - 87.26' and 30" Maple - N25W - 55.65')

This corner is accepted as a careful and faithful perpetuation of the position of the original corner.

C. Description of monument for corner and accessories established to perpetuate locating the position of the corner:

1995: Set 1/2" iron rod with .3" dia. aluminum cap, stamped to identify the corner.

Witnesses are:

Existing 50 penny nail in 6" R. Pine - N23E - 87.26'

Existing 50 penny nail in 30" Maple - N25W - 55.65'

Set tag #31591 in 20" Maple - N18W - 73.94'


Set tag #31591 in 5" Cherry - S15E - 76.97'

Signed by

Thomas L. Fabis

Surveyor's Michigan License No.

31591

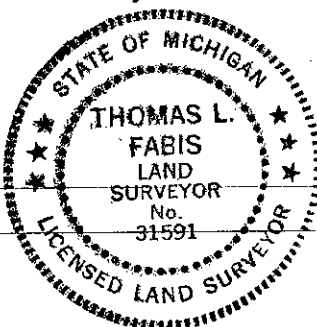

Date

September 27, 1995