

SURVEY & REMONUMENTATION

Alcona County Remonumentation Liber 1 Page 136

APPROVED LAND CORNER P A 345 of 1990 ALCONA COUNTY Date 10-2-95 County Rep. RECORDED E.T.L.

OCT 26 1995

1995 ALCONA COUNTY REMONUMENTATION CORNER

LAND CORNER RECORDATION CERTIFICATE Filing Requirement of Act 74, Mich. P.A. 1970

COMMISSION

For corners in


Table with columns: Alcona (County), Located In, Corner Code. Row 1: Public Land Survey, T 27N R 9E, E-5 (SW,9) (Haynes Twp.).

OCT 2 2 36 PM '95

Signature of David A. Pattison, REGISTER OF DEEDS ALCONA COUNTY MICHIGAN

Alcona County Remonumentation Liber 1 Page 136 Register of Deeds Stamp & File Number

- 4. Lot No. Recorded Plat
5. Private Claims

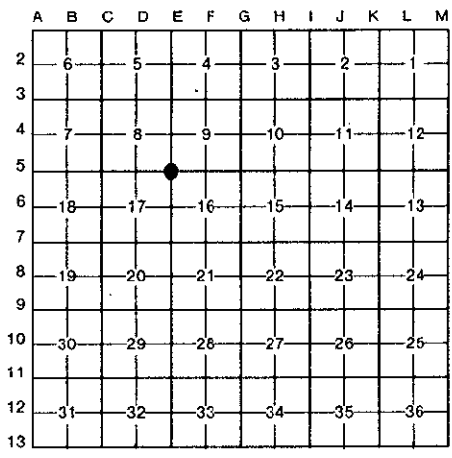

I, Thomas L. Fabis, in a field survey on September 15, 1995, do hereby certify that under requirements of P.A. 74, Michigan P.A. of 1970, the corner points mentioned in lines 1 and 2 above were in conformance with regulations and rules therefore as required in the current manual of survey instructions of the United States Department of the Interior, Bureau of Land Management or by a decree of a Court of Law and/or that the corner points mentioned in lines 3, 4 and 5 above were in conformance with the rules of the Michigan Board of Land Surveyors or by a Decree of a Court of Law, established, re-established, monumented, re-monumented, recovered, found as expressed below.


NOTE: Not more than 4 corners, all in the same town and range, may be recorded on this certificate.

- A. Description of original monument and accessories and/or subsequent restoration:
1840: G.L.O. Survey by Thos. Pattison - Set post & referenced: (Cedar 10 - N26E - 14, Cedar 14 - S36W - 22)
1889: County Survey - Describes it as a nearly square light gray boulder with "x" on top and broken brick & glass under it.
1953: Road Alignment Survey by R.S. Scott Engineering Co. Inc. - Boat Spike and witnesses: (Tele. Pole - Northwest - 77.9' and N.E. Cor. Cooks Store - Southwest - 67.1')

- B. Description of corner evidence found and/or method applied in restoring or reestablishing corner:
1995: Found existing Boat Spike 2' below road surface as per 1953 Road Alignment Survey by R.S. Scott Engineering Co. Inc. Corner position fits well with 1/8 line fences to the North and to the South, also checks with distances to the Quarter Corners to the East and to the West when compared to the 1953 Road Alignment Stationing. This corner is accepted as a careful and faithful perpetuation of the position of the original corner.

- C. Description of monument for corner and accessories established to perpetuate locating the position of the corner:
1995: Set 1/2" iron rod with 3" dia. brass cap, stamped to identify the corner, inside a Monument Box.
Reestablished witnesses are:
Set tag #31591 in 2" Scarlet Maple - S45W - 55.50'
Set tag #31591 in 6" W. Spruce - N45W - 70.82'
Set tag #31591 in 5" W. Spruce - N30W - 65.37'
Set tag #31591 in 6" Apple - N36E - 68.24'

Signed by Thomas L. Fabis, Surveyor's Michigan License No. 31591

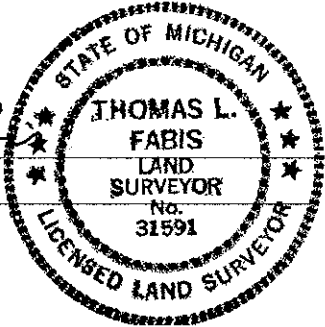

Date September 27, 1995