

SURVEY & REMONUMENTATION

FEB 19 1999

SECTION

1998 Alcona County Remonumentation Corner LAND CORNER RECORDATION CERTIFICATE Filing Requirement of Act 74, Mich. P.A. 1970

Alcona County
Remonumentation

For corners in

<u>Alcona</u> (County)	Located In:	Corner Code #	
1. Public Land Survey	T <u>27N</u> R <u>9E</u>	<u>E-9</u>	
	T _____ R _____	_____	
	T _____ R _____	_____	
	T _____ R _____	_____	
2. Property Controlling in Section	S _____ T _____ R _____	_____	
	S _____ T _____ R _____	_____	
3. Miscellaneous Property in Sec.	S _____ T _____ R _____	_____	
	S _____ T _____ R _____	_____	

Filed for Record in 1 Page 311
ALCONA COUNTY MICHIGAN
DORIS A GAUTHIER
On 12-11-1998 At 03:31:02 pm.
LAND CORNER 9.00
OR

LAND CORNER
P.A. 345 of 1990
ALCONA COUNTY
Date 9/22/98
County Rep. D.T. Kibbe
Register of Deeds Stamp & File Number

4. Lot No. _____, Recorded Plat _____
5. Private Claims _____

I, Daniel T. Kibbe, in a field survey on April 8, 1998 do hereby state that under requirements of P.A. 74, Michigan P.A. of 1970, the corner points mentioned in lines 1 and 2 above were in conformance with regulations and rules therefore as required in the current manual of survey instructions of the United States Department of the Interior, Bureau of Land Management or by a decree of a Court of Law and /or that the corner points mentioned in lines 3, 4 and 5 above were in conformance with the rules of the Michigan Board of Land Surveyors or by a Decree of a Court of Law; established, re-established, monumented, recovered, found as expressed below:

NOTE: Not more than 2 corners, all in the same town and range, may be recorded on this certificate.

	A	B	C	D	E	F	G	H	I	J	K	L
1												
2	6		5		4		3		2			1
3												
4	7		8		9		10		11			12
5												
6	18		17		16		15		14			13
7												
8	19		20		21		22		23			24
9												
10	30		29		28		27		26			25
11												
12	31		32		33		34		35			36
13												

A. Description of original monument and accessories and/or subsequent restoration:

- 1840: GLO Survey by Thos. Pattison - Set corner post, referenced: Beech 10-N58W-45/Beech 7-S17E-60
- 1907: County Survey by Edward Chapell - Light-gray boulder 9x18, old R.R. braking iron under it
- 1908: County Survey by A.J. Freer - Ran to corner, referenced: W. Pine stump 34"-N59W-38 links/W. Pine stump 28"-S41E-38 links
- 1978: Survey by John F. Oliver, Recorded Liber 174 pg 245 - Referenced corner
- 1979: Recorded corner by John F. Oliver, LCRC Liber 1 pg 79 - Found 1/2" bar, referenced: 8" Apple-S41W-65.25'/Tel. Pole-N50W-55.20/P. Pole-S39E-74.65'
- 1996: Field Notes by Hank Grush - Found 1/2" rebar


B. Description of corner evidence found and/or method applied in restoring or reestablishing corner:

- 1998: Remon Survey by Daniel T. Kibbe - Found 1/2" rebar C.L. roads N, S, E & W

This corner position is compatible with county & local surveys. This corner position is accepted as a careful and faithful perpetuation of the position of the original corner.

C. Description of monument for corner and accessories established to perpetuate locating the position of the corner:

- 1998: Placed 3" Alcona County cap stamped to identify the corner over 1/2" iron rod in monument box.
Referenced:
Found nail in P. Pole-S36E-74.63'
Set tag in Apple-S41W-65-06'
Set tag in Fence Post-N40W-58.17'
E edge of Stop sign-N15W-65.80'

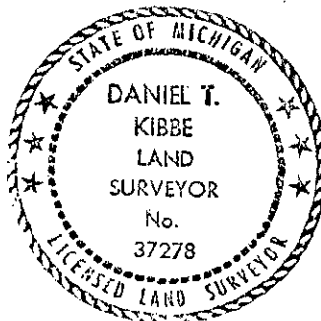

Signed by Daniel T. Kibbe
Surveyor's Michigan License No. 37278

Date December 7, 1998