

SURVEY & REMONUMENTATION

DEC 16 1996

COMMISSION

1996 ALCONA COUNTY REMONUMENTATION CORNER

LAND CORNER RECORDATION CERTIFICATE
Filing Requirement of Act 74, Mich. P.A. 1970

Alcona County
 Remonumentation
 Liber 1 Page 04

For corners in Alcona
 (County)

Located In:

Corner Code #

- 1. Public Land Survey T 27N R 9E
- T R
- T R
- T R
- 2. Property Controlling S T R
- in Section S T R
- 3. Miscellaneous S T R
- Property in Section S T R

F-5
 Haynes Twp.

APPROVED LAND CORNER
 P.A. 345 of 1990
 ALCONA COUNTY
 Date 11-15-96
 County Rep. E.L.L.


RECORDED

045 111 30



Register of Deeds Stamp & File Number

- 4. Lot No. _____, Recorded Plat _____
- 5. Private Claims _____

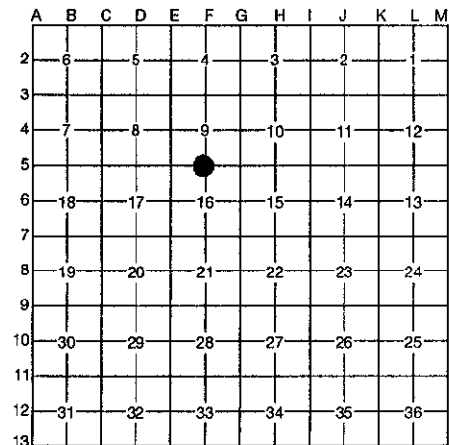

I, Thomas L. Fabis, in a field survey on November 8, 1996, do hereby certify that under requirements of P.A. 74, Michigan P.A. of 1970, the corner points mentioned in lines 1 and 2 above were in conformance with regulations and rules therefore as required in the current manual of survey instructions of the United States Department of the Interior, Bureau of Land Management or by a decree of a Court of Law and/or that the corner points mentioned in lines 3, 4 and 5 above were in conformance with the rules of the Michigan Board of Professional Surveyors or by a Decree of a Court of Law; established, re-established, monumented, re-monumented, recovered, found as expressed below:

NOTE: Not more than 4 corners, all in the same town and range, may be recorded on this certificate.

A. Description of original monument and accessories and/or subsequent restoration:

- 1840: G.L.O. Survey by Thos. Pattison - Set post and referenced: (Hem 18 - S40E - 22, Hem 9 - N60W - 28)
- Early County Survey by Ed Chapelle - Visited corner & referenced: (Y. Birch 20 - S67W - 1.18)
- 1953: Road Alignment Survey by R.S. Scott Engineering Co. - 1/2" Rod and referenced: (NW - 78.4' - Fence Post, SW - 38.7' - Fence Post)


B. Description of corner evidence found and/or method applied in restoring or reestablishing corner:

1996: Did not find any existing physical corner material or monumentation. Set 1/2" iron rod at intersection of centerline of E-W paved road and 1/4 line fence to the North.

The position of this corner is compatible with the 1953 Road Survey and is accepted as the best available evidence of the position of the original corner.

C. Description of monument for corner and accessories established to perpetuate locating the position of the corner:

- 1996: Set 3" dia. Brass cap, stamped to identify corner over a 1/2" iron rod and set a Monument Box around corner.
- Set tags #31591 in the following reestablished witnesses:
 - 7" W. Pine - N62E - 64.64'
 - 6" Aspen - N40E - 33.29'
 - 4" Apple - S22W - 59.71'
 - 12" W. Pine - S22E - 100.88'

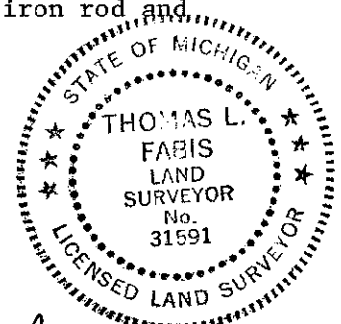

Signed by Thomas L. Fabis

Date November 14, 1996

Surveyor's Michigan License No. 31591