

# SURVEY & REMONUMENTATION

FEB 19 1999

## SECTION

### 1998 Alcona County Remonumentation Corner LAND CORNER RECORDATION CERTIFICATE Filing Requirement of Act 74, Mich. P.A. 1970

Alcona County  
Remonumentation

For corners in

<u>Alcona</u> (County)	Located In:	Corner Code #	
1. Public Land Survey	T <u>27N</u> R <u>9E</u>	<u>G-4</u>	
	T _____ R _____	_____	
	T _____ R _____	_____	
	T _____ R _____	_____	
2. Property Controlling in Section	S _____ T _____ R _____	_____	
	S _____ T _____ R _____	_____	
3. Miscellaneous Property in Sec.	S _____ T _____ R _____	_____	
	S _____ T _____ R _____	_____	

Filed for Record in Liber 1 Page 314  
ALCONA COUNTY MICHIGAN  
DORIS A GAUTHIER  
On 12-11-1998 At 03:31:26 pm.  
LAND CORNER 9.00  
OR

APPROVED LAND CORNER  
P.A. 345 of 1990  
ALCONA COUNTY  
Date 9/22/98  
County Rep. D.T. Kibbe

Register of Deeds Stamp & File Number

4. Lot No. \_\_\_\_\_, Recorded Plat \_\_\_\_\_  
5. Private Claims \_\_\_\_\_

I, Daniel T. Kibbe, in a field survey on April 8, 1998 do hereby state that under requirements of P.A. 74, Michigan P.A. of 1970, the corner points mentioned in lines 1 and 2 above were in conformance with regulations and rules therefore as required in the current manual of survey instructions of the United States Department of the Interior, Bureau of Land Management or by a decree of a Court of Law and for that the corner points mentioned in lines 3, 4 and 5 above were in conformance with the rules of the Michigan Board of Land Surveyors or by a Decree of a Court of Law; established, re-established, monumented, recovered, found as expressed below:

NOTE: Not more than 2 corners, all in the same town and range, may be recorded on this certificate.

1	A	B	C	D	E	F	G	H	I	J	K	L
2	6		5			4		3		2		1
3												
4	7		8			9	10		11			12
5												
6	18		17			16		15		14		13
7												
8	19		20			21		22		23		24
9												
10	30		29			28		27		26		25
11												
12	31		32			33		34		35		36
13												

**A. Description of original monument and accessories and/or subsequent restoration:**

- 1840: GLO Survey by Thos. Pattison - Set 1/4 section post, referenced: Beech 12-N65E-28/Beech 12-S32W-28
- 1899: County Survey by Edward Chaspell - Found Corner post. Set gray boulder 9x12x26 W/x" on top. Glass & crockery with it.
- 1981: Survey by John F. Oliver - Recorded Liber 186 pg 349 - Found 1/2" bar.


**B. Description of corner evidence found and/or method applied in restoring or reestablishing corner:**

- 1998: Remon Survey by Daniel T. Kibbe - Found 1/2" rebar C.L. road E & W. C.L. road to S.

This corner position is compatible with county & local surveys. This corner position is accepted as a careful and faithful perpetuation of the position of the original corner.

**C. Description of monument for corner and accessories established to perpetuate locating the position of the corner:**

- 1998: Placed 3" Alcona County cap stamped to identify the corner over 1/2" iron rod in monument box.  
Referenced:  
Set tag in P. Pole-S51W-66.25'  
Found Geodetic survey marker-N45W-34.84'  
Set tag in 13" Poplar-N50E-84.30'  
Set tag in 28" Cottonwood-S44E-130.30'

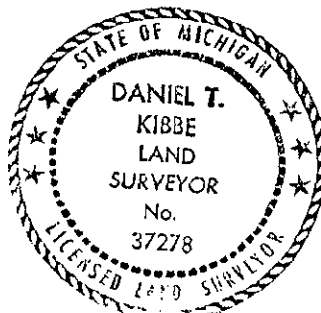

Signed by Daniel T. Kibbe  
Surveyor's Michigan License No. 37278

Date December 7, 1998