

SURVEY & REMONUMENTATION

DEC 16 1996

COMMISSION

1996 ALCONA COUNTY REMONUMENTATION CORNER **Alcona County**
LAND CORNER RECORDATION CERTIFICATE Remonumentation
 Filing Requirement of Act 74, Mich. P.A. 1970 Liber 1 Page 200

For corners in Alcona (County) Located In: _____ Corner Code # _____

1. Public Land Survey	T <u>27N</u> R <u>9E</u>	G-5
	T _____ R _____	Haynes Tw
	T _____ R _____	
	T _____ R _____	
2. Property Controlling in Section	S _____ T _____ R _____	
	S _____ T _____ R _____	
3. Miscellaneous Property in Section	S _____ T _____ R _____	
	S _____ T _____ R _____	

RECORDED
 Nov 18 8 45 AM '96
James A. Guethin
 REGISTER OF DEEDS
 ALCONA COUNTY
 Register of Deeds Stamp & File Number

4. Lot No. _____, Recorded Plat _____
 5. Private Claims _____

I, Thomas L. Fabis, in a field survey on November 8, 1996, do hereby certify that under requirements of P.A. 74, Michigan P.A. of 1970, the corner points mentioned in lines 1 and 2 above were in conformance with regulations and rules therefore as required in the current manual of survey instructions of the United States Department of the Interior, Bureau of Land Management or by a decree of a Court of Law and/or that the corner points mentioned in lines 3, 4 and 5 above were in conformance with the rules of the Michigan Board of Professional Surveyors or by a Decree of a Court of Law; established, re-established, monumented, re-monumented, recovered, found as expressed below:

NOTE: Not more than 4 corners, all in the same town and range, may be recorded on this certificate.

A. Description of original monument and accessories and/or subsequent restoration:

- 1840: G.L.O. Survey by Thos. Pattison - Set post & referenced: (Beech 7 - S15W - 25, Beech 6 - N42E - 15)
- Early County Survey: (Surveyor Unknown) Corner Post - gray boulder 12 x 18 + on top, crockery & old iron under it.
- 1953: Road Alignment Survey by R.S. Scott Engineering Co. - 1/2" Rod and referenced.


B. Description of corner evidence found and/or method applied in restoring or reestablishing corner:

1996: Found 1/2" iron rod in the intersection of paved roads N & S and West.

The location of this iron is compatible with the 1953 R.S. Scott Road Survey and is accepted as a careful and faithful perpetuation of the position of the original corner.

C. Description of monument for corner and accessories established to perpetuate locating the position of the corner:

- 1996: Set 3" dia. brass cap, stamped to identify the corner over the existing 1/2" iron rod, and set a Monument Box around it.
- Reestablished witnesses are:
 - 4" Apple - N55E - 48.25'
 - 3" Pine - S50E - 56.19'
 - 2" Pine - S70W - 77.50'
 - 12" W. Pine - S40E - 96.82'

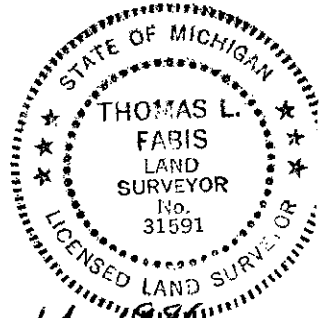

Signed by Thomas L. Fabis Date November 14, 1996
 Surveyor's Michigan License No. 31591

