

**SURVEY & REMONUMENTATION**

**FEB 19 1999**

**SECTION**

**1998 Alcona County Remonumentation Corner  
LAND CORNER RECORDATION CERTIFICATE  
Filing Requirement of Act 74, Mich. P.A. 1970**

For corners in

<u>Alcona</u> (County)	Located In:	Corner Code #
1. Public Land Survey	T <u>27N</u> R <u>9E</u>	<u>G-7</u>
	T _____ R _____	_____
	T _____ R _____	_____
	T _____ R _____	_____
2. Property Controlling in Section	S _____ T _____ R _____	_____
	S _____ T _____ R _____	_____
3. Miscellaneous Property in Sec.	S _____ T _____ R _____	_____
	S _____ T _____ R _____	_____

Alcona County Remonumentation  
Filed for Record in \_\_\_\_\_ Page 316  
ALCONA COUNTY MICHIGAN  
DORIS A GAUTHIER  
On 12-11-1998 At 03:31:34 pm.  
LAND CORNER 9.00  
OR

APPROVED LAND CORNER  
P A 345 of 1990  
ALCONA COUNTY  
Date 9/22/98  
County Rep. D. T. Kibbe

Register of Deeds Stamp & File Number

4. Lot No. \_\_\_\_\_, Recorded Plat \_\_\_\_\_  
5. Private Claims \_\_\_\_\_

1	A	B	C	D	E	F	G	H	I	J	K	L
2		6		5		4		3		2		1
3												
4		7		8		9		10		11		12
5												
6		16		17		16		15		14		13
7												
8		19		20		21		22		23		24
9												
10		30		29		28		27		26		25
11												
12		31		32		33		34		35		36
13												

I, Daniel T. Kibbe, in a field survey on April 8, 1998 do hereby state that under requirements of P.A. 74, Michigan P.A. of 1970, the corner points mentioned in lines 1 and 2 above were in conformance with regulations and rules therefore as required in the current manual of survey instructions of the United States Department of the Interior, Bureau of Land Management or by a decree of a Court of Law and /or that the corner points mentioned in lines 3, 4 and 5 above were in conformance with the rules of the Michigan Board of Land Surveyors or by a Decree of a Court of Law; established, re-established, monumented, recovered, found as expressed below:

**NOTE:** Not more than 2 corners, all in the same town and range, may be recorded on this certificate.

**A. Description of original monument and accessories and/or subsequent restoration:**

1840: GLO Survey by Thos. Pattison - Set corner section post, Referenced: Beech 7-S67E-23/Beech 12-N35W-15  
1997: Survey by John F. Oliver - Found corner - not identified.

**B. Description of corner evidence found and/or method applied in restoring or reestablishing corner:**


1998: Remon Survey by Daniel T. Kibbe - Found RR spike C.L. road N & S C.L. road E & W.

This corner position is compatible with county & local surveys. This corner position is accepted as a careful and faithful perpetuation of the position of the original corner.

**C. Description of monument for corner and accessories established to perpetuate locating the position of the corner:**

1998: Placed 3" Alcona County cap stamped to identify the corner over 1/2" iron rod in monument box.  
Referenced:

- Found tag in P. Pole (27452)-S40W-74.62'
- Found tag in P. Pole (22455)-S61W-111.15'
- Found tag in P. Pole (35737)-N44W-122.62'
- Found tag in P. Pole (27452)-S65E-177.50'

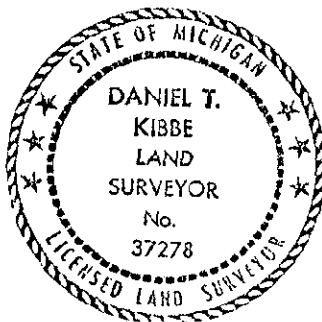

Signed by Daniel T. Kibbe  
Surveyor's Michigan License No. 37278

Date December 7, 1998