

**SURVEY & REMONUMENTATION**

APR 21 1994

1993 ALCONA COUNTY REMONUMENTATION CORNER

**LAND CORNER RECORDATION CERTIFICATE**

Filing Requirement of Act 74, Mich. P.A. 1970

COMMISSION  
For corners in

RECORDED

Remon Liber 1 Page 45

DEC 21 4 23 PM '93


*Doris A. Guthrie*  
REGISTER OF DEEDS  
ALCONA COUNTY, MICHIGAN

Register of Deeds Stamp & File Number

Atcona (County) Located In: Corner Code #

1. Public Land Survey	T <u>27N</u> R <u>9E</u>	<u>K - 3</u>
	T _____ R _____	_____
	T _____ R _____	_____
	T _____ R _____	_____
2. Property Controlling in Section	S _____ T _____ R _____	_____
	S _____ T _____ R _____	_____
3. Miscellaneous Property in Sec.	S _____ T _____ R _____	_____
	S _____ T _____ R _____	_____

4. Lot No. \_\_\_\_\_, Recorded Plat \_\_\_\_\_  
5. Private Claims \_\_\_\_\_

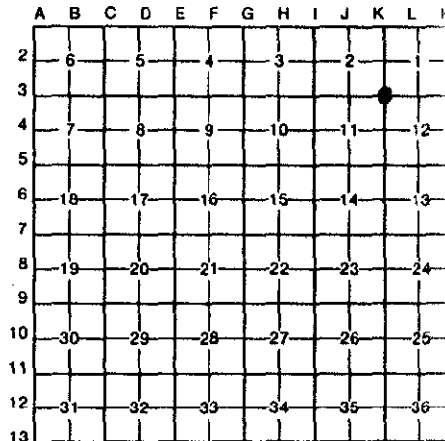

I, **Duane R. MacNeill**, in a field survey on August 3, 19 93, do hereby certify that under requirements of P.A. 74, Michigan P.A. of 1970, the corner points mentioned in lines 1 and 2 above were in conformance with regulations and rules therefore as required in the current manual of survey instructions of the United States Department of the Interior, Bureau of Land Management or by a decree of a Court of Law and/or that the corner points mentioned in lines 3, 4 and 5 above were in conformance with the rules of the Michigan Board of Land Surveyors or by a Decree of a Court of Law; established, re-established, monumented, re-monumented, recovered, found as expressed below:

**NOTE: Not more than 4 corners, all in the same town and range, may be recorded on this certificate.**

A. Description of original monument and accessories and/or subsequent restoration:

1839 - Set by U.S. Deputy Surveyor

Witnesses:

Beech 6 S7W25  
Lynn 16 N72E28

1975 - D.R. MacNeill P.S. #19237 found an old leaf spring set at this location. Set 1" pipe with cap #19237 next to leaf spring.

Witnesses:

West 19.50' 8" White Birch  
S 80° E 25.12' 6" Aspen  
S 70° W 5.85' 14" Aspen

B. Description of corner evidence found and/or method applied in restoring or reestablishing corner:

1993 - Found 1" pipe with cap #19237 during remonumentation field work.

1989 - 1" pipe found and recorded by Thomas L. Fabis P.S. #31591.

Witnesses:

S 85° W 13.5' 12" Balsam  
S 70° E 26.65' 6" Balsam  
N 60° W 19.6' 8" Birch  
S 80° W 6.0' 15" Aspen

C. Description of monument for corner and accessories established to perpetuate locating the position of the corner:

Alcona County Remonumentation, Aluminum Cap, appropriately secured to re-rod driven into 1" pipe, appropriately stamped.

Witnesses:

N 76° W 13.38' 18" Balsam  
N 54° W 19.68' 7" Birch  
S 62° E 26.62' 6" Balsam  
S 50° W 35.38' 8" Balsam

Witnesses were freshened as necessary; nails replaced with duplex nails bearing a brass washer stamped license #19237

Signed by *Duane R. MacNeill* Date December 16, 1993  
Surveyor's Michigan License No. 19237

