

SURVEY & REMONUMENTATION

DEC 16 1996

COMMISSION

1996 ALCONA COUNTY REMONUMENTATION CORNER

Alcona County
Remonumentation
Liber 1 Page 205

LAND CORNER RECORDATION CERTIFICATE
Filing Requirement of Act 74, Mich. P.A. 1970

For corners in
Alcona
(County)

Located In: Corner Code #

RECORDED

- 1. Public Land Survey T 26N R 9E
T R
T R
T 27N R 9E
- 2. Property Controlling in Section S T R
S T R
- 3. Miscellaneous S T R
Property in Section S T R

K-1
Harrisville Twp.

K-13

Haynes Twp.

APPROVED LAND CORNER
P.A. 345 of 1990
ALCONA COUNTY

Date 11/15/96
County Reg. 11/15/96

18 8 45 10 '96

Thomas L. Fabis
REGISTERED LAND SURVEYOR

Register of Deeds Stamp & File Number

- 4. Lot No. _____, Recorded Plat _____
- 5. Private Claims _____

T26N - R9E

	A	B	C	D	E	F	G	H	I	J	K	L	M
2	6		5		4		3		2				
3													
4	7		8		9		10		11				
5													
6	18		17		16		15		14				
7													
8	19		20		21		22		23				
9													
10	30		29		28		27		26				
11													
12	31		32		33		34		35				
13													

I, Thomas L. Fabis, in a field survey on November 8, 1996, do hereby certify that under requirements of P.A. 74, Michigan P.A. of 1970, the corner points mentioned in lines 1 and 2 above were in conformance with regulations and rules therefore as required in the current manual of survey instructions of the United States Department of the Interior, Bureau of Land Management or by a decree of a Court of Law and/or that the corner points mentioned in lines 3, 4 and 5 above were in conformance with the rules of the Michigan Board of Professional Surveyors or by a Decree of a Court of Law; established, re-established, monumented, re-monumented, recovered, found as expressed below:

NOTE: Not more than 4 corners, all in the same town and range, may be recorded on this certificate.

A. Description of original monument and accessories and/or subsequent restoration:

- 1830: G.L.O. Survey by Lewis Clason - Set Post & referenced: (Beech 14 - S7W - 26, B. Oak 20 - S53E - 31)
- 1843: G.L.O. Survey by Lewis Clason - Intersected N. Boundary at Post.
- 1901: County Survey by Ed Chapelle - Visited corner & referenced.
- 1905: County Survey by Ed Chapelle - Visited corner & referenced.
- 1939: County Survey by Andrew Freer - Set window weight 18" long & 1 1/2" dia.
- 1979: Survey (R.S. Scott W.O. 1-1144) by David Guthrie - Set 1/2" iron rod & referenced.

B. Description of corner evidence found and/or method applied in restoring or reestablishing corner:

- 1996: Found 1/2" iron rod 6' North of centerline of gravel road and 3 existing witnesses: (N20E - 24" Oak - 19.56', N70E - 14" Aspen - 41.91', NORTH - 1/2" iron rod N.E.L.S. - 33.00')


The position of this corner is compatible with county and local surveys and is accepted as a careful and faithful perpetuation of the position of the original corner.

C. Description of monument for corner and accessories established to perpetuate locating the position of the corner:

- 1996: Set 3" dia. aluminum cap, stamped to identify the corner, over the existing 1/2" iron rod, 6" below gravel surface.

References:

- Existing tag #22435 in 24" Oak - N20E - 19.56'
- Existing tag #22435 in 14" Aspen - N70E - 41.91'
- Set tag #31591 in 9" Twin Birch - S50W - 51.70'
- Set tag #31591 in 18" Oak - S2E - 31.94'
- 1/2" iron rod N.E.L.S. - North - 33.00'

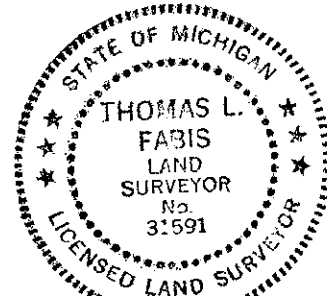

Signed by Thomas L. Fabis

Date November 13, 1996

Surveyor's Michigan License No. 31591