

*London*

*B-11 seg 1*

1994 Alcona County Remonumentation Corner

LAND CORNER RECORDATION CERTIFICATE  
Filing Requirement of Act 74, Mich. P.A. 1970

Alcona County  
Remonumentation  
RECORDED  
Page 82

For corners in

Alcona  
(County)

Located In:

Corner Code #

- 1. Public Land Survey T 28N R 5E
- T \_\_\_\_\_ R \_\_\_\_\_
- T \_\_\_\_\_ R \_\_\_\_\_
- T \_\_\_\_\_ R \_\_\_\_\_
- 2. Property Controlling S \_\_\_\_\_ T \_\_\_\_\_ R \_\_\_\_\_
- in Section S \_\_\_\_\_ T \_\_\_\_\_ R \_\_\_\_\_
- 3. Miscellaneous S \_\_\_\_\_ T \_\_\_\_\_ R \_\_\_\_\_
- Property in Sec. S \_\_\_\_\_ T \_\_\_\_\_ R \_\_\_\_\_

APPROVED LAND CORNER  
 P.A. 345 of 1990  
 ALCONA COUNTY  
 Date 12-16-94  
 County Rep. E.J.L.

DEC 19 12 15 PM '94

*David A. Guthrie*  
 REGISTER OF DEEDS  
 ALCONA COUNTY MICHIGAN  
 E.J.L.

Register of Deeds Stamp & File Number

- 4. Lot No. \_\_\_\_\_, Recorded Plat \_\_\_\_\_
- 5. Private Claims \_\_\_\_\_

A	B	C	D	E	F	G	H	I	J	K	L
2	6	5	4	3	2						
3											
4	7	8	9	10	11	12					
5											
6	13	17	16	15	14	13					
7											
8	19	20	21	22	23	24					
9											
10	30	29	28	27	26	25					
11											
12	31	32	33	34	35	36					
13											

I, David B. Guthrie in a field survey on June 6, 1994, do hereby certify that under requirements of P.A. 74, Michigan P.A. of 1970, the corner points mentioned in lines 1 and 2 above were in conformance with regulations and rules therefore as required in the current manual of survey instructions of the United States Department of the Interior, Bureau of Land Management or by a decree of a Court of Law and/or that the corner points mentioned in lines 3, 4 and 5 above were in conformance with the rules of the Michigan Board of Land Surveyors or by a Decree of a Court of Law; established, re-established, monumented, re-monumented, recovered, found as expressed below:

**NOTE: Not more than 4 corners, all in the same town and range, may be recorded on this certificate.**

A. Description of original monument and accessories and/or subsequent restoration:


- 1840: G.L.O. Survey by Thos. Pattison - Used 12" Sugar Maple for corner no references.
- 1910: Survey by W.S. Freer - Set Pine stake 4"x4" - referenced Fence Post - S77°W - 66 Links
- 1987: Survey by D.R. MacNeill and Assoc.
- 1993: Survey by D.R. MacNeill and Assoc. - Found 1" Pipe

B. Description of corner evidence found and/or method applied in restoring or reestablishing corner:

- 1994: Found P.K. Nail which is compatible with D.R. MacNeill and Assoc. surveys, did not find 1" Pipe.

C. Description of monument for corner and accessories established to perpetuate locating the position of the corner:

- 1994: Replaced with a 5/8" Iron Rod with a 3" Aluminum Cap stamped to identify the Corner set in a Monument Box.  
 Referenced -  
 N50°W - 15" Basswood - 155.25 Feet  
 S52°W - 14" W.Pine - 78.18 Feet  
 S16°E - Anchor Pole - 23.53 Feet  
 N25°E - Utility Pole - 31.00 Feet

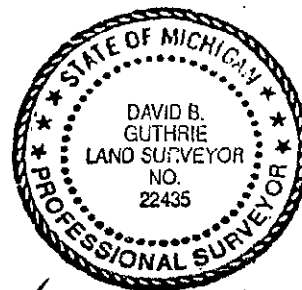

Signed by *David B. Guthrie*

Date 12/16/94

Surveyor's Michigan License No. 22435