

MAR 03 2000

1999 ALCONA COUNTY REMONUMENTATION CORNER

SECTION

LAND CORNER RECORDATION CERTIFICATE  
Filing Requirement of Act 74, Mich. P.A. 1970

Alcona County  
Remonumentation  
Liber 2 Page 11

For corners in

<u>Alcona</u> (County)	Located in:	Corner Code #
1. Public Land Survey	T28N R5E	G-5
	T <u>    </u> R <u>    </u>	<u>Mitchell</u> Twp.
	T <u>    </u> R <u>    </u>	<u>    </u>
	T <u>    </u> R <u>    </u>	<u>    </u>
2. Property Controlling in Section	S <u>    </u> T <u>    </u> R <u>    </u>	<u>    </u>
	S <u>    </u> T <u>    </u> R <u>    </u>	<u>    </u>
3. Miscellaneous Property in Sec.	S <u>    </u> T <u>    </u> R <u>    </u>	<u>    </u>
	S <u>    </u> T <u>    </u> R <u>    </u>	<u>    </u>

Filed for Record in  
ALCONA COUNTY MICHIGAN  
DORIS A GAUTHIER  
On 12-17-1999 At 10:07 am.  
LAND CORNER 9.00

Register of Deeds Stamp & File Number

4. Lot No. \_\_\_\_\_, Recorded Plat \_\_\_\_\_  
5. Private Claims \_\_\_\_\_

I, Thomas L. Fabis, in a field survey on Aug. 30, 1999 do hereby state that under requirements of P.A. 74, Michigan P.A. of 1970, the corner points mentioned in lines 1 and 2 above were in conformance with regulations and rules therefore as required in the current manual of survey instructions of the United States Department of the Interior, Bureau of Land Management or by a decree of a Court of Law and /or that the corner points mentioned in lines 3, 4 and 5 above were in conformance with the rules of the Michigan Board of Land Surveyors or by a Decree of a Court of Law; established, re-established, monumented, recovered, found as expressed below:

NOTE: Not more than 2 corners, all in the same town and range, may be recorded on this certificate.

A	B	C	D	E	F	G	H	I	J	K	L	M
1												
2	6		5		4		3		2		1	
3												
4	7		8		9		10		11		12	
5												
6	18		17		16		15		14		13	
7												
8	19		20		21		22		23		24	
9												
10	30		29		28		27		26		25	
11												
12	31		32		33		34		35		36	
13												

A. Description of original monument and accessories and/or subsequent restoration:

- 1840: G.L.O. Survey Thomas Pattison set post & referenced: W. Pine 24 N40W 19, Y. Pine 22 S60E 21.
- 1913 & 1916: County Survey W.S. Freer Oak stake 3x3 3 foot long.
- 1959 & 1960: M.D.O.T. Witness Card & Road Plans Norm Caldwell found 1" Iron Bar same 3/4" Iron Rod 5.15 Rt. of M-65 centerline & referenced.
- 1991: Survey Liber 245 Pages 565 & 567 Duane MacNeill found Mon. Box 5.15 East of M-65 centerline.
- 1996: NELS Survey for Richard Roquepaw by Bill Woods found 3/4" Rod in Mon. Box.

B. Description of corner evidence found and/or method applied in restoring or reestablishing corner:


- 1999: Found 1" iron reinforcing rod in Mon. Box 5.15 feet East of M-65 centerline. Also, found 2 existing witnesses.

The position of this corner is compatible with M.D.O.T., local and county surveys and is accepted as a careful and faithful perpetuation of the position of the original corner.

C. Description of monument for corner and accessories established to perpetuate locating the position of the corner:

- 1999: Removed existing 1" iron reinforcing rod and replaced with 1/2" iron rod with a 3" dia. brass cap, stamped to identify the corner, inside the existing Mon. Box.  
Witnesses are:  
Exis. Spike in 11" J. Pine N37E 74.33  
Exis. Spike in P. Pole N67E 79.92  
Set tag #31591 in 6" J. Pine S67E 98.87  
Set tag #31591 in 4" J. Pine N64W 65.48

APPROVED LAND CORNER  
P A 345 of 1990  
ALCONA COUNTY  
Date 9/23/99  
County Rep. [Signature]

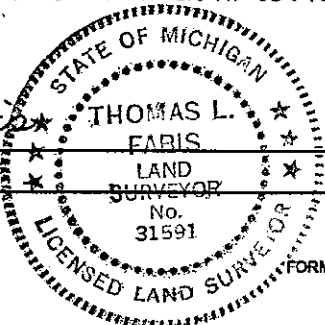

Signed by Thomas L. Fabis  
Surveyor's Michigan License No. 31591

Date November 30, 1999