MAR 0 3 2000

SECTION

1999 Alcona County Remonumentation Corner
LAND CORNER RECORDATION CERTIFICATE
Filing Requirement of Act 74, Mich. P.A. 1970

Alcona County Remonumentation Liber 2 Page 34

For corners in

Alcona (County)

	Located In:	Corner Code #
1. Public Land Survey	T 28N R5E	G-8
	T____ R____	
	T____ R____	
	T____ R____	
2. Property Controlling	S____ T____ R____	
in Section	S____ T____ R____	
3. Miscellaneous	S____ T____ R____	
Property in Sec.	S____ T____ R____	

Filed for Record in
ALCONA COUNTY MICHIGAN
DORIS A GAUTHIER
On 12-17-1999 At 10:55 am.
LAND CORNER 9.00

Register of Deeds Stamp & File Number

4. Lot No. _____ , Recorded Plat _____
5. Private Claims _____

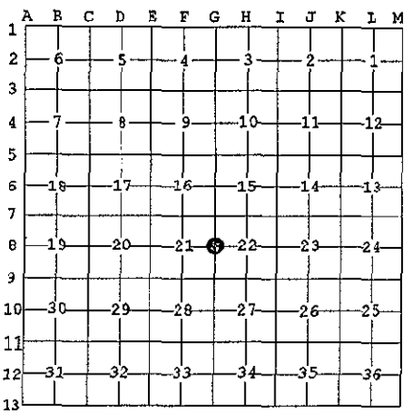

I, Daniel T. Kibbe, in a field survey on June 2, 19 99 do hereby state that under requirements of P.A. 74, Michigan P.A. of 1970, the corner points mentioned in lines 1 and 2 above were in conformance with regulations and rules therefore as required in the current manual of survey instructions of the United States Department of the Interior, Bureau of Land Management or by a decree of a Court of Law and /or that the corner points mentioned in lines 3, 4 and 5 above were in conformance with the rules of the Michigan Board of Land Surveyors or by a Decree of a Court of Law; established, re-established, monumented, recovered, found as expressed below:

NOTE: Not more than 2 corners, all in the same town and range, may be recorded on this certificate

A. Description of original monument and accessories and/or subsequent restoration:

1840: GLO Survey by Thos. Pattison-Set 1/4 post: Referenced: W. Pine 28-N68E-18
1959: MDOT Survey by Norman C. Caldwell-No evidence of corner

B. Description of corner evidence found and/or method applied in restoring or reestablishing corner:

1999: Remon. Survey by Daniel T. Kibbe-No corner or evidence found. No well defined occupation lines will help in determining corner position. Contractor, therefore, proposes to establish 1/4 corner at an S.P. position. This corner position is accepted as a careful and faithful perpetuation of the position of the original corner.

C. Description of monument for corner and accessories established to perpetuate locating the position of the corner:

1999: Placed 3" Alcona County cap stamped to identify the corner over ½" iron rod in monument box.
Referenced:
15" R. Pine-set tag-N70E 79.42'
15" R. Pine-set tag-S58E 104.04'
P. Pole-set tag-N50W 56.85'
15" R. Pine set tag-S61W 90.13'

APPROVED LAND CORNER
P A 345 of 1990
ALCONA COUNTY
Date 9/23/99
County Rep. D.D.C.

Signed by Daniel T. Kibbe

Date November 30, 1999

Surveyor's Michigan License No. 37278

STATE OF MICHIGAN
DANIEL T. KIBBE
LAND SURVEYOR
No. 37278
LICENSED LAND SURVEYOR

FORM APPROVED BY MICHIGAN STATE BOARD OF PROFESSIONAL SURVEYORS, JAN. 28, 197
REVISED MAY 14, 197
REVISED JAN., 198
REVISED OCT., 199