

RF SURVEY & RECORDS

MAR 03 2000

1999 ALCONA COUNTY REMONUMENTATION CORNER

LAND CORNER RECORDATION CERTIFICATE  
Filing Requirement of Act 74, Mich. P.A. 1970

Alcona County  
Remonumentation  
Liber 2 Page 8

SECTION  
For corners in

<u>Alcona</u> (County)	Located In:	Corner Code #
1. Public Land Survey	T <u>28</u> R <u>5E</u>	H-1
	T ___ R ___	<u>Mitchell Twp.</u>
	T ___ R ___	_____
	T ___ R ___	_____
2. Property Controlling in Section	S ___ T ___ R ___	_____
	S ___ T ___ R ___	_____
3. Miscellaneous Property in Sec.	S ___ T ___ R ___	_____
	S ___ T ___ R ___	_____
4. Lot No. _____, Recorded Plat _____		
5. Private Claims _____		

Filed for Record in  
ALCONA COUNTY MICHIGAN  
DORIS A GAUTHIER  
On 12-17-1999 At 10:07 am.  
LAND CORNER 9.00

Register of Deeds Stamp & File Number

I, Thomas L. Fabis, in a field survey on Sept. 2, 1999 do hereby state that under requirements of P.A. 74, Michigan P.A. of 1970, the corner points mentioned in lines 1 and 2 above were in conformance with regulations and rules therefore as required in the current manual of survey instructions of the United States Department of the Interior, Bureau of Land Management or by a decree of a Court of Law and /or that the corner points mentioned in lines 3, 4 and 5 above were in conformance with the rules of the Michigan Board of Land Surveyors or by a Decree of a Court of Law, established, re-established, monumented, recovered, found as expressed below:

NOTE: Not more than 2 corners, all in the same town and range, may be recorded on this certificate.

1	A	B	C	D	E	F	G	H	I	J	K	L	M
2	6		5		4		3		2		1		
3													
4	7		8		9		10		11		12		
5													
6	10		17		16		15		14		13		
7													
8	19		20		21		22		23		24		
9													
10	30		29		28		27		26		25		
11													
12	31		32		33		34		35		36		
13													


A. Description of original monument and accessories and/or subsequent restoration:  
Note: This corner was not set during the original Gov't. Survey.  
1998: Survey NELS Job No. B3285 980810 Bill Woods Used corner to set 1/8 line to the West.

B. Description of corner evidence found and/or method applied in restoring or reestablishing corner:  
1999: Found Spring Leaf in centerline of gravel road (Doctor's Club Rd.). Distance measured to the West indicates that this is the same corner used by Bill Woods.

The position of this corner is compatible with local surveys and is accepted as a careful and faithful perpetuation of the position of the corner.

C. Description of monument for corner and accessories established to perpetuate locating the position of the corner:  
1999: Removed Spring Leaf and replaced it with a 1/2" iron rod with a 3" dia. alum. cap, stamped to identify the corner. Set tag #31591 in the following witnesses:  
12" Oak N25E 49.84  
8" W. Pine S37E 29.82  
12" Oak South 30.55  
15" Oak S34W 37.72

APPROVED LAND CORNER  
P A 345 of 1990  
ALCONA COUNTY  
Date 9/23/99  
County Rep. Paul R. [Signature]

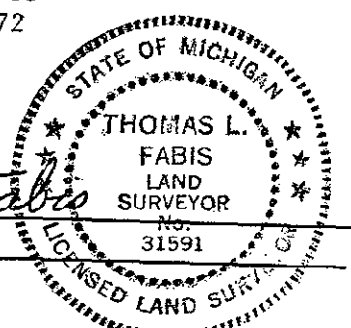

Signed by Thomas L. Fabis  
Surveyor's Michigan License No. 31591

Date November 30, 1999